

Pike
D 2022
5/25/77

MISSISSIPPI
BOARD OF WATER COMMISSIONERS
416 North State Street
Jackson, Mississippi 39201

WATER WELL DRILLERS LOG

5-25
date well completed

1977 Itz...
firm name

Pike
county well located

LANDOWNER:

Charles Palermo

Chas. Palermo
(mailing address)

description of formations
encountered

from

to

Red Clay

0

25

Red Soil

20

110

Common Soil + gravel

116

130

WELL LOCATION:

sec. 21 T. 3 (N) S R. 7 (E) W

3 miles W of McComb
(distance) (direction) (nearest town)

WELL PURPOSE:

Home
(home, irrigation, municipal, industrial)

WELL COMPLETION DATA:

- (1) diameter (inches) 4
(2) total depth (feet) 130
(3) static water level (feet) 70 below
top of ground.

- (4) casing PVC, 122,
(material) (depth)

4 if telescope see back.
(size)

- (5) screen 8, 122
(length) (depth to top)

4, PVC
(size) (material)

- (6) pump 3/4, 15
(HP) (yield gpm)

elec
(type power)

- (7) electric log no
(yes or no)

(organization running log)

- (8) how well bottom plugged Good thick


DRILLERS REMARKS:

RECEIVED
JUL 5 - 1977

MISS. BD. OF WATER COMMISSIONERS

If well telescopes please
sketch and show depths.

GROUND LEVEL

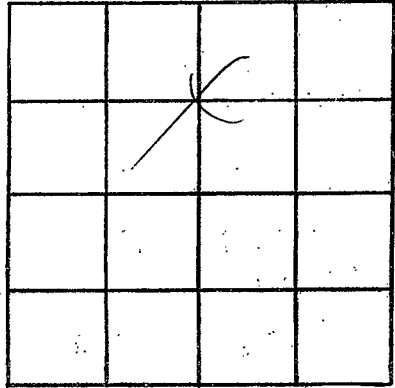

SECTION 21

Please indicate well location X.

ADDITIONAL INFORMATION

If more than one screen,
show locations of each on sketch.