

**MISSISSIPPI  
BOARD OF WATER COMMISSIONERS**  
416 North State Street  
Jackson, Mississippi 39201

**WATER WELL DRILLERS LOG**

Pike  
D 2023  
6-4-77

June 4 1977 Gretn Water Well Cont. Pike  
date well completed firm name county well located

**LANDOWNER:**  
Lee Dixon  
Route 2, Box 234  
McComb, Miss.  
(mailing address)

description of formations encountered	from	to
<u>Citronelle</u>	<u>1</u>	<u>124</u>

**WELL LOCATION:**  
sec. 34 T. 3 N R. 7E  
4 miles SW of McComb  
(distance) (direction) (nearest town)

**WELL PURPOSE:** home  
(home, irrigation, municipal, industrial)

**WELL COMPLETION DATA:**

(1) diameter (inches) 6

(2) total depth (feet) 124

(3) static water level (feet) 55 below top of ground.

(4) casing PVC 118'  
(material) (depth)  
4" if telescope see back.  
(size)

(5) screen 6' 118'  
(length) (depth to top)  
010 PVC  
(size) (material)

(6) pump 1/2 sub. 10  
(HP) (yield gpm)  
electricity  
(type power)

(7) electric log no  
(yes or no)

(organization running log)

(8) how well bottom plugged back wash valve


**RECEIVED**  
JUN 14 1977

DRILLERS REMARKS: \_\_\_\_\_

MISS. BLD. OF WATER COMMISSIONERS

If well telescopes please sketch and show depths.

GROUND LEVEL

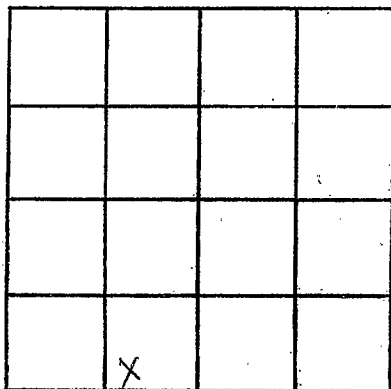

SECTION 34

Please indicate well location X.

ADDITIONAL INFORMATION

If more than one screen, show locations of each on sketch.