

Pike
D
9-9-77

MISSISSIPPI
BOARD OF WATER COMMISSIONERS
416 North State Street
Jackson, Mississippi 39201

WATER WELL DRILLERS LOG

9-9
date well completed

1977 Fitzgerald Well Service
firm name

Pike
county well located


LANDOWNER:	description of formations encountered	from	to
<u>Keith Sanders</u>			
<u>R.R. McComb Miss.</u> (mailing address)	<u>Red clay</u> <u>Red sand</u> <u>Coarse sand & gravel</u>	<u>0</u> <u>20</u> <u>70</u>	<u>20</u> <u>70</u> <u>103</u>
<p>WELL LOCATION:</p> <p>sec. <u>28</u> T <u>3</u> N <u>5</u> S R <u>7</u> E <u>W</u></p> <p><u>3</u> miles <u>SW</u> of <u>McComb</u> (distance) (direction) (nearest town)</p>			
<p>WELL PURPOSE: <u>Home</u> (home, irrigation, municipal, industrial)</p>			
<p>WELL COMPLETION DATA:</p> <p>(1) diameter (inches) <u>4</u></p> <p>(2) total depth (feet) <u>103</u></p> <p>(3) static water level (feet) <u>45</u> below above top of ground.</p> <p>(4) casing <u>Plc</u>, <u>95</u> (material) (depth) <u>4</u> if telescope see back. (size)</p> <p>(5) screen <u>8</u>, <u>95</u> (length) (depth to top) <u>4</u>, <u>Plc</u> (size) (material)</p> <p>(6) pump <u>3/4</u>, <u>15</u> (HP) (yield gpm) <u>elec</u> (type power)</p> <p>(7) electric log <u>No</u> (yes or no) (organization running log)</p> <p>(8) how well bottom plugged <u>Sandstone</u></p>			
<p>DRILLERS REMARKS:</p>			

RECEIVED
OCT 31 1977

MISS. BD. OF WATER COMM

If well telescopes please sketch and show depths.

GROUND LEVEL

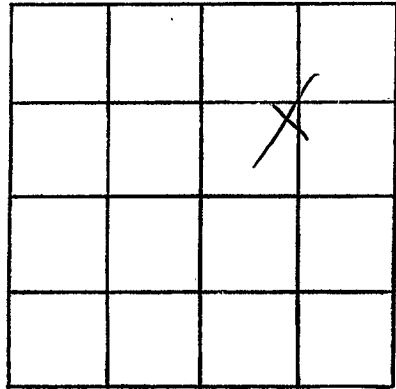

SECTION 28

Please indicate well location X.

ADDITIONAL INFORMATION

If more than one screen,
show locations of each on sketch.

✓