

PIKE
D 2057
2-16-78

MISSISSIPPI
 BOARD OF WATER COMMISSIONERS
 416 North State Street
 Jackson, Mississippi 39201

WATER WELL DRILLERS LOG

Feb-16 1978 Beever weller Pike
 date well completed firm name county well located

LANDOWNER:
Mark Velt
P. O. Box McComb
 (mailing address)

description of formations encountered	from	to
<u>sandy</u>	<u>0</u>	<u>10</u>
<u>sand & gravel</u>	<u>10</u>	<u>40</u>
<u>Chalk & gravel</u>	<u>40</u>	<u>80</u>
<u>gravel & sand</u>	<u>80</u>	<u>97</u>

WELL LOCATION:
 sec. 21 T. 5 N R. 7 E
3 miles S-S West McComb
 (distance) (direction) (nearest town)

WELL PURPOSE: game
 (home, irrigation, municipal, industrial)

- WELL COMPLETION DATA:
- (1) diameter (inches) 4"
 - (2) total depth (feet) 97
 - (3) static water level (feet) 50 below above top of ground.
 - (4) casing plastic Cotton
 (material) (depth)
 if telescope see back.
 (size)
 - (5) screen 5' 92'
 (length) (depth to top)
4" plastic
 (size) (material)
 - (6) pump 3 sub 12
 (HP) (yield gpm)
elect
 (type power)
 - (7) electric log no
 (yes or no)
- (organization running log)


(8) how well bottom plugged
water plug

DRILLERS REMARKS:

RECEIVED
 MAY 11 1978

If well telescopes please sketch and show depths.

GROUND LEVEL

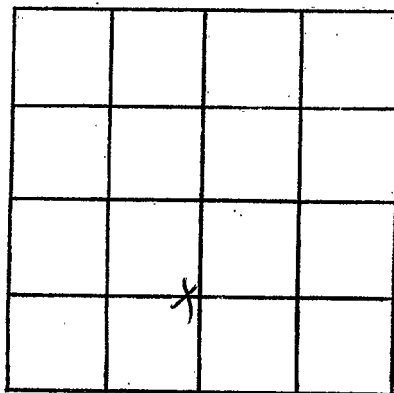

SECTION 21

Please indicate well location X.

ADDITIONAL INFORMATION

If more than one screen,
show locations of each on sketch.