

Pike
 D 2030
 6-12-79

MISSISSIPPI
 BOARD OF WATER COMMISSIONERS
 416 North State Street
 Jackson, Mississippi 39201

WATER WELL DRILLERS LOG

June 12 1979 Reussmiller Pike
 date well completed firm name county well located

LANDOWNER:
 Mr. J. C. Johnston
 1031 Pope Circle
 (mailing address)

WELL LOCATION:
 sec. 11 T 3 N R 7 E
 in McComb
 (distance) (direction) (nearest town)

WELL PURPOSE: Fish pond
 (home, irrigation, municipal, industrial)

WELL COMPLETION DATA:
 (1) diameter (inches) 4"
 (2) total depth (feet) 104
 (3) static water level (feet) 50 below top of ground.
 (4) casing Plastic bottom (material) (depth)
 (size) if telescope see back.
 (5) screen 10' 94' (length) (depth to top)
 4" Plastic (size) (material)
 (6) pump 1-hp 20 (HP) (yield gpm)
 elect (type power)
 (7) electric log no (yes or no)
 (organization running log)

(8) how well bottom plugged
 wooden plug

DRILLERS REMARKS:


description of formations encountered	from to	
Red Clay	0	17
Chalky sand	17	55
small gravel	55	70
Hard sand	70	70
Chalky gravel		
small gravel	70	104
to shale		

DEPT. OF NATURAL RESOURCES
 BUREAU OF LAND & WATER RESOURCES

JAN 22 1980
 RECEIVED

If well telescopes please sketch and show depths.

GROUND LEVEL

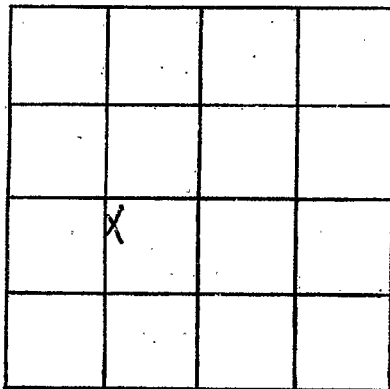

SECTION 11

Please indicate well location X.

ADDITIONAL INFORMATION

If more than one screen, show locations of each on sketch.