

Pike

D 2031

4-10-80

4-10
date well completed

MISSISSIPPI
BOARD OF WATER COMMISSIONERS
416 North State Street
Jackson, Mississippi 39201

WATER WELL DRILLERS LOG

1980 Fitzgerald well ser
firm name

Pike
county well located

LANDOWNER:

W.W. Williamson

RR #1
(mailing address)

WELL LOCATION:

sec. 15 T. 3 N. R. 7 E
S W
1 1/2 miles W of m. Lomb
(distance) (direction) (nearest town)

WELL PURPOSE: Home
(home, irrigation, municipal, industrial)

WELL COMPLETION DATA:

- (1) diameter (inches) 4
- (2) total depth (feet) 132
- (3) static water level (feet) 85 below above top of ground.
- (4) casing PVC, 126, (material) (depth)
4 (size) if telescope see back.
- (5) screen 8, 126 (length) (depth to top)
4 (size) PVC (material)
- (6) pump 1/2 (HP) 10 (yield gpm)
class (type power)
- (7) electric log no (yes or/no)
- (8) how well bottom plugged Sand Shale

description of formations encountered

from to

Red clay	0	20
Red sandstone	20	80
Red sand	80	120
Coarse sandstone	120	132

DRILLERS REMARKS:


DEPT. OF NATURAL RESOURCES
BUREAU OF LAND & WATER RESOURCES

JUN 20 1980

RECEIVED

If well telescopes please sketch and show depths.

GROUND LEVEL

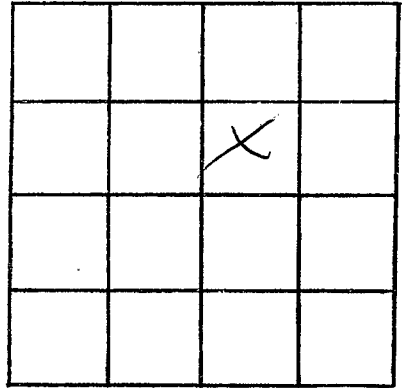

SECTION 15

Please indicate well location X.

ADDITIONAL INFORMATION

If more than one screen, show locations of each on sketch.