

MISSISSIPPI DEPARTMENT OF NATURAL RESOURCES

Bureau of Land and Water Resources

Southport Mall

P.O. Box 10631

Jackson, Mississippi 39209

WATER WELL DRILLERS LOG

Pike  
D 2032  
12-13-80

Dec 13 1980  
date well completed

Reuss Well Dr  
firm name

Pike  
county well located


LANDOWNER:  
J. Hugh Tate  
Rt Summit  
(mailing address)

description of formations encountered	from to	
Clay	0	12
sand & gravel	12	48
Hard Rock	48	52
Brown sand	52	66
sand rock	66	71
brown sand	71	90
gravel & sand	90	104

WELL LOCATION:  
sec. 6 T. 3 N R. 7 E  
5 1/2 miles west of McComb  
(distance) (direction) (nearest town)

WELL PURPOSE: house  
(home, irrigation, municipal, industrial)

- WELL COMPLETION DATA:
- (1) diameter (inches) 04"
  - (2) total depth (feet) 104'
  - (3) static water level (feet) 18' below top of ground
  - (4) casing plaster, button  
(material) (depth)
  - (5) screen 5' 99'  
(length) (depth to top)
  - (6) pump 4" plaster  
(size) (material)
  - (7) pump 1/2 HP by other  
(type power) (yield gpm)
  - (8) electric log 20  
(yes or no)
  - (organization running log)

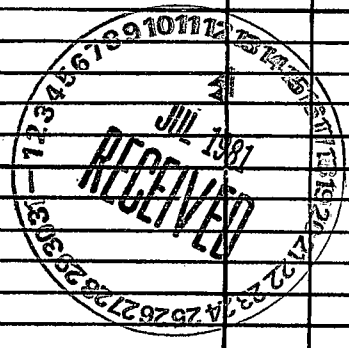


(8) how well bottom plugged  
backwash valve

DRILLERS REMARKS:  
Bad hole  
sand rocks

If well telescopes please sketch and show depths.

GROUND LEVEL

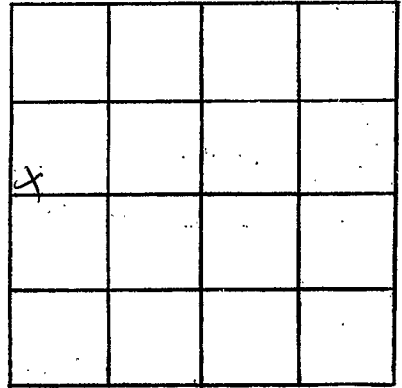

SECTION 6

Please indicate well location X.

ADDITIONAL INFORMATION

If more than one screen, show locations of each on sketch.