

Pike
 D 2033
 9-24-81

MISSISSIPPI
 BOARD OF WATER COMMISSIONERS
 416 North State Street
 Jackson, Mississippi 39201


WATER WELL DRILLERS LOG

9-24 1981 Fitzgould Well Service Pike
 date well completed firm name county well located

LANDOWNER:	description of formations encountered	from	to
PHILLIP O'BRIEN RR. 3 m 46 (mailing address)	Red clay Red sand Brown sand & gravel	0 20 30	20 30 70
WELL LOCATION: sec. 14 T-3 N R-2 E 1/2 miles W of m comb (distance) (direction) (nearest town)			
WELL PURPOSE: (home, irrigation, municipal, industrial)			
WELL COMPLETION DATA: (1) diameter (inches) 4 (2) total depth (feet) 72 (3) static water level (feet) 10 below top of ground. (4) casing PVC, 64 (depth) 4 (size) if telescope see back. (5) screen 8 (length), 64 (depth to top) 4 (size), 8 (material) (6) pump 1 1/2 (HP), 25 (yield gpm) blue (type power) (7) electric log yes (yes or no) (organization running log) (8) how well bottom plugged <u>Full</u>			
DRILLERS REMARKS:	DEPT. OF NATURAL RESOURCES BUREAU OF LAND & WATER RESOURCES SEP 20 1981 RECEIVED		

If well telescopes please sketch and show depths.

GROUND LEVEL

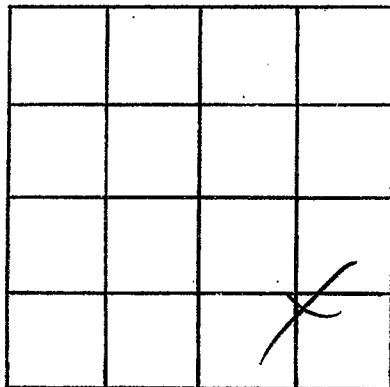

SECTION 14

Please indicate well location X.

ADDITIONAL INFORMATION

If more than one screen,
show locations of each on sketch.