

MISSISSIPPI DEPARTMENT OF NATURAL RESOURCES

Bureau of Land and Water Resources

Southport Mall

P.O. Box 10631


Jackson, Mississippi 39209

WATER WELL DRILLERS LOG

Pike
D 2034
3-29-81


March 29 1981 Revernuller Pike
 date well completed firm name county well located

LANDOWNER:	description of formations encountered.	from	to
<u>Ted Adams</u> <u>Rt 1 McComb</u> (mailing address)	<u>clay</u> <u>red cherty sand</u> <u>pea gravel sand</u>	<u>0</u> <u>17</u> <u>115</u>	<u>17</u> <u>45</u> <u>64</u>
WELL LOCATION: sec <u>23</u> T <u>3</u> N R <u>7</u> E <u>1/2</u> miles <u>South</u> of <u>McComb</u> (distance) (direction) (nearest town)			
WELL PURPOSE: <u>Trailer</u> (home, irrigation, municipal, industrial)			
WELL COMPLETION DATA: (1) diameter (inches) <u>4"</u> (2) total depth (feet) <u>64'</u> (3) static water level (feet) <u>38'</u> below above top of ground. (4) casing <u>plastic bottom</u> (material) (depth) _____ if telescope see back. (size) (5) screen <u>0'</u> <u>59'</u> (length) (depth to top) <u>4"</u> <u>plastic</u> (size) (material) (6) pump <u>lyatron</u> (HP) (yield gpm) <u>elect</u> (type power) (7) electric log <u>no</u> (yes or no) _____ (organization running log) (8) how well bottom plugged <u>back wash</u>			
DRILLERS REMARKS: _____			

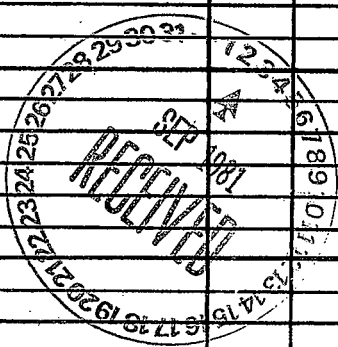

If well telescopes please sketch and show depths.

GROUND LEVEL

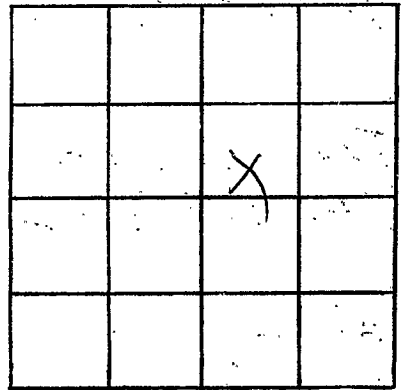

SECTION 23

Please indicate well location X.

ADDITIONAL INFORMATION

If more than one screen, show locations of each on sketch.