

MISSISSIPPI DEPARTMENT OF NATURAL RESOURCES

Bureau of Land and Water Resources

Southport Mall

P.O. Box 10631

Jackson, Mississippi 39209

WATER WELL DRILLERS LOG

PIKE
D 2035
6/17/81

June 19 1981 Acum W M Sa Pike
 date well completed firm name county well located

LANDOWNER:
Sterling Ellis
McLone
 (mailing address)

description of formations encountered	from	to
<u>sandy clay</u>	<u>0</u>	<u>17</u>
<u>yellow sand</u>	<u>17</u>	<u>85</u>
<u>gravel</u>	<u>85</u>	<u>106</u>
<u>blue clay</u>	<u>106</u>	<u>180</u>
<u>coarse sand & gravel</u>	<u>180</u>	<u>208</u>

WELL LOCATION:
 sec. 10 T. 3 N R. 7 E
1 miles west of McLone
 (distance) (direction) (nearest town)

WELL PURPOSE: home
 (home, irrigation, municipal, industrial)

- WELL COMPLETION DATA:
- (1) diameter (inches) 4"
 - (2) total depth (feet) 208
 - (3) static water level (feet) 63 below top of ground.
 - (4) casing plastic (material) bottom (depth)
 - (size) If telescope see back.
 - (5) screen 10" (length) 198' (depth to top)
 - 4" (size) plastic (material)
 - (6) pump by other (HP) (yield gpm)
 - electric (type power)
 - (7) electric log no (yes or no)
 - (organization running log)

(8) how well bottom plugged
backwash

DRILLERS REMARKS:
✓


PT. OF NATURAL RESOURCES
 BUREAU OF LAND & WATER RESOURCES

JAN 4 - 1982

RECEIVED

If well telescopes please sketch and show depths.

GROUND LEVEL

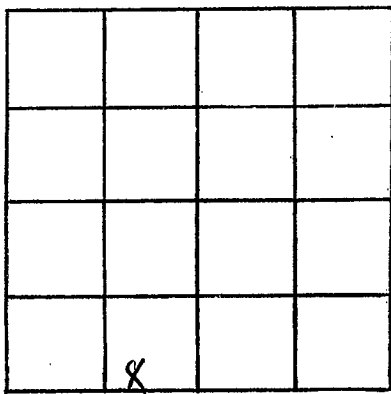

SECTION 10

Please indicate well location X.

ADDITIONAL INFORMATION

If more than one screen,
show locations of each on sketch.