

Pike  
D  
2038

MISSISSIPPI  
BOARD OF WATER COMMISSIONERS  
416 North State Street  
Jackson, Mississippi 39201

WATER WELL DRILLERS LOG

6-30 1982 Stallham Pike  
date well completed firm name county well located

LANDOWNER:	description of formations encountered	from	to
<u>Mark Stallham</u>			
<u>R.R. McComb</u> (mailing address)	<u>Reel clay</u>	<u>2</u>	<u>20</u>
	<u>Red sand &amp; gravel</u>	<u>20</u>	<u>50</u>
	<u>Reel gravel</u>	<u>50</u>	<u>100</u>
	<u>Concrete sand &amp; gravel</u>	<u>100</u>	<u>110</u>
WELL LOCATION:			
sec. <u>19</u> T <u>3</u> N R <u>2</u> E S W			
<u>5</u> miles <u>W</u> of <u>McComb</u> (distance) (direction) (nearest town)			
WELL PURPOSE:			
<u>Flow</u> (home, irrigation, municipal, industrial)			
WELL COMPLETION DATA:			
(1) diameter (inches) <u>4</u>			
(2) total depth (feet) <u>110</u>			
(3) static water level (feet) <u>25</u> below top of ground.			
(4) casing <u>PVC</u> , <u>102</u> , (material) (depth)			
<u>4</u> if telescope see back. (size)			
(5) screen <u>8</u> , <u>102</u> (length) (depth to top)			
<u>4</u> , <u>PVC</u> (size) (material)			
(6) pump <u>1/2</u> , <u>10</u> (HP) (yield gpm)			
<u>Wells</u> (type power)			
(7) electric log <u>no</u> (yes or no)			
<u>Stallham</u> (organization running log)			
(8) how well bottom plugged <u>Stallham</u>			
DRILLERS REMARKS:			


DEPT. OF NATURAL RESOURCES  
BUREAU OF LAND & WATER RESOURCES

JUL 7 1982

RECEIVED

If well telescopes please sketch and show depths.

GROUND LEVEL

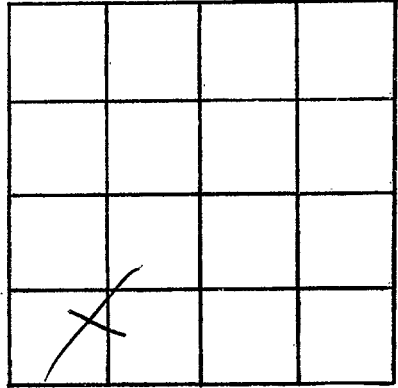

SECTION 19

Please indicate well location X.

ADDITIONAL INFORMATION

If more than one screen,  
show locations of each on sketch.