

Pike
D 2057

MISSISSIPPI
 BOARD OF WATER COMMISSIONERS
 416 North State Street
 Jackson, Mississippi 39201

WATER WELL DRILLERS LOG

9-30
 date well completed

1982 Fitzgerald & Co
 firm name

Pike
 county well located

LANDOWNER:	description of formations encountered	from	to
<u>Ray Swanby</u> <u>R.R. McComb</u> (mailing address)			
WELL LOCATION:			
sec. <u>8</u> T. <u>3</u> N R. <u>2</u> E S W			
<u>5</u> miles <u>W</u> of <u>McComb</u> (distance) (direction) (nearest town)			
WELL PURPOSE: (home, irrigation, municipal, industrial)			
WELL COMPLETION DATA:			
(1) diameter (inches) <u>4</u>			
(2) total depth (feet) <u>78</u>			
(3) static water level (feet) <u>52</u> below top of ground.			
(4) casing <u>PVC, 70</u> , (material) (depth) <u>4</u> If telescope see back. (size)			
(5) screen <u>8</u> , <u>70</u> . (length) (depth to top) <u>4</u> , <u>PVC</u> (size) (material)			
(6) pump <u>1/2</u> , <u>10</u> (HP) (yield gpm) <u>ole</u> (type power)			
(7) electric log <u>no</u> (yes or no)			
(8) how well bottom plugged <u>Seal shell</u>			
DRILLERS REMARKS:			


DEPT. OF NATURAL RESOURCES
 BUREAU OF LAND & WATER RESOURCES

OCT 18 1982

RECEIVED

If well telescopes please sketch and show depths.

GROUND LEVEL

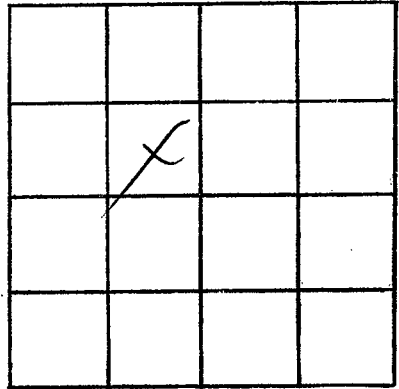

SECTION 8

Please indicate well location X.

ADDITIONAL INFORMATION

If more than one screen,
show locations of each on sketch.