

MISSISSIPPI DEPARTMENT OF NATURAL RESOURCES
 Bureau of Land and Water Resources
 Southport Mall
 P.O. Box 10631
 Jackson, Mississippi 39209
WATER WELL DRILLERS LOG

PIKE
D
2043

Jan 26 1983 Reeves Well Co Pike
 date well completed firm name county well located

LANDOWNER:
W. R. (Bill) Catching
Mc Comb
 (mailing address)

description of formations encountered	from	to
<u>Clay & gravel</u>	<u>0</u>	<u>16</u>
<u>sand</u>	<u>16</u>	<u>40</u>
<u>Chalky, lobbly</u>	<u>40</u>	<u>80</u>
<u>gravel & sand</u>	<u>80</u>	<u>95</u>

WELL LOCATION:
 sec. 2 T 3 N R 7 E
8 20
 miles of
 (distance) (direction) (nearest town)

WELL PURPOSE: Home
 (home, irrigation, municipal, industrial)

WELL COMPLETION DATA:

(1) diameter (inches) 4"

(2) total depth (feet) 95

(3) static water level (feet) 45 below
 top of ground. above.

(4) casing Plastic Cotton
 (material) (depth)

 If telescope see back.
 (size)

(5) screen 5' 90'
 (length) (depth to top)

4" Plastic
 (size) (material)

(6) pump 1/2 10
 (HP) (yield gpm)

elect
 (type power)

(7) electric log no
 (yes or no)

 (organization running log)

(8) how well bottom plugged
back was

DRILLERS REMARKS:


DEPT. OF NATURAL RESOURCES
 BUREAU OF LAND & WATER RESOURCES

APR 27 1983

RECEIVED

If well telescopes please sketch and show depths.

GROUND LEVEL

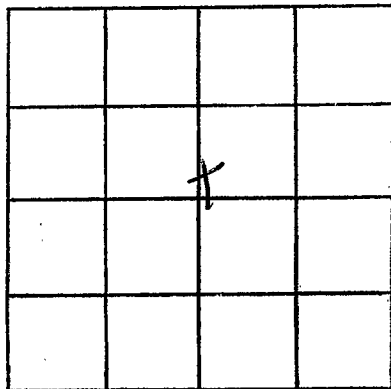

SECTION 2

Please indicate well location X.

ADDITIONAL INFORMATION

If more than one screen,
show locations of each on sketch.