

PIKE
D
2044

MISSISSIPPI DEPARTMENT OF NATURAL RESOURCES
 Bureau of Land and Water Resources
 Southport Mall
 P.O. Box 10631
 Jackson, Mississippi 39209
WATER WELL DRILLERS LOG

Feb 8 1983 Rever Well Ser Pike
 date well completed firm name county well located

LANDOWNER:	description of formations encountered	from	to
A. V. Hudson Rt 1 McComb - (mailing address)			
WELL LOCATION: sec <u>22</u> T <u>3</u> N R <u>7</u> E <u>1-1/2</u> miles <u>N.S.W.</u> of <u>McComb</u> (distance) (direction) (nearest town)			
WELL PURPOSE: <u>Trailer</u> (home, irrigation, municipal, industrial)			
WELL COMPLETION DATA:			
(1) diameter (inches) <u>4"</u>			
(2) total depth (feet) <u>115</u>			
(3) static water level (feet) <u>75</u> below top of ground.			
(4) casing <u>plastic bottom</u> (material) (depth)			
<u>1</u> If telescope see back. (size)			
(5) screen <u>5</u> <u>110</u> (length) (depth to top)			
<u>4"</u> <u>plastic</u> (size) (material)			
(6) pump <u>10</u> (HP) (yield gpm)			
<u>Elect</u> (type power)			
(7) electric log <u>no</u> (yes or no)			
<u> </u> (organization running log)			
(8) how well bottom plugged <u>partial</u>			
DRILLERS REMARKS:			


DEPT. OF NATURAL RESOURCES
 BUREAU OF LAND & WATER RESOURCES

APR 27 1983

RECEIVED

If well telescopes please sketch and show depths.

GROUND LEVEL

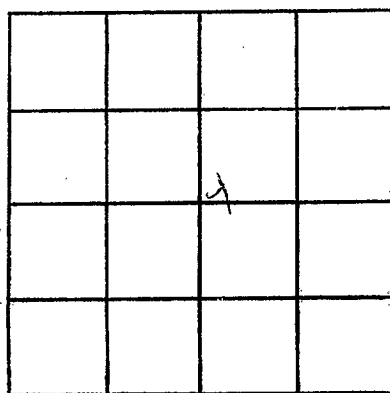

SECTION 22

Please indicate well location X.

ADDITIONAL INFORMATION

If more than one screen, show locations of each on sketch.