

MISSISSIPPI DEPARTMENT OF NATURAL RESOURCES

Bureau of Land and Water Resources

Southport Mall

P.O. Box 10631

Jackson, Mississippi 39209

WATER WELL DRILLERS LOG

<b>PIKE</b>
<b>D</b>
2045

June 13 1983 Reverend Pike Pike  
 date well completed firm name county well located

LANDOWNER:	description of formations encountered	from	to
<u>Fernwood Golf Court (Fernwood)</u> (mailing address)			
WELL LOCATION: sec. <u>36</u> T <u>3</u> N R <u>7</u> E <u>1/2</u> miles <u>west</u> of <u>Fernwood</u> (distance) (direction) (nearest town)	<u>sandy clay</u> <u>sand + gravel</u> <u>chalk</u> <u>sand</u> <u>pebbles + sand</u>	<u>0</u> <u>22</u> <u>85</u> <u>160</u> <u>180</u>	<u>22</u> <u>85</u> <u>160</u> <u>180</u> <u>204</u>
WELL PURPOSE: <u>irrigation</u> (home, irrigation, municipal, industrial)			
WELL COMPLETION DATA:			
(1) diameter (inches) <u>4"</u>			
(2) total depth (feet) <u>204</u>			
(3) static water level (feet) <u>50</u> below top of ground.			
(4) casing <u>plastic baton</u> (material) (depth)			
<u>        </u> If telescope see back. (size)			
(5) screen <u>20"</u> , <u>184"</u> (length) (depth to top)			
<u>4"</u> , <u>plastic</u> (size) (material)			
(6) pump <u>5 Sub</u> <u>87"</u> (HP) (yield gpm)			
<u>elect</u> (type power)			
(7) electric log <u>no</u> (yes or no)			
<u>        </u> (organization running log)			
(8) how well bottom plugged <u>Good Wash</u>			
DRILLERS REMARKS: <u>none</u>			

*Well made 60ft apart*


DEPT. OF NATURAL RESOURCES  
BUREAU OF LAND & WATER RESOURCES

SEP 28 1993

RECEIVED

If well telescopes please sketch and show depths.

GROUND LEVEL

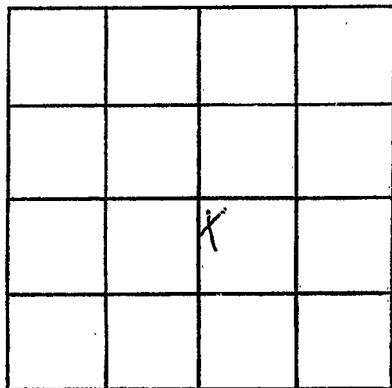

SECTION 36

Please indicate well location X.

ADDITIONAL INFORMATION

If more than one screen, show locations of each on sketch.