

MISSISSIPPI DEPARTMENT OF NATURAL RESOURCES

Bureau of Land and Water Resources

Southport Mall

P.O. Box 10631

Jackson, Mississippi 39209

WATER WELL DRILLERS LOG

Pike
D
2047

June 14 1983 Pewee Miller Pike
 date well completed firm name county well located

LANDOWNER:	description of formations encountered	from	to
<u>Fernwood Golf Court (Fernwood)</u> (mailing address)			
	<u>gravel</u>	<u>22</u>	<u>52</u>
	<u>blue chalk - sand</u>	<u>52</u>	<u>160</u>
	<u>Red granite sand</u>	<u>160</u>	<u>178</u>
		<u>178</u>	<u>197</u>

WELL LOCATION:
 sec 36 T 3 N R 7 E
2 miles west of Fernwood
 (distance) (direction) (nearest town)

WELL PURPOSE: irrigation
 (home, irrigation, municipal, industrial)

- WELL COMPLETION DATA:
- (1) diameter (inches) 4"
 - (2) total depth (feet) 197
 - (3) static water level (feet) 50 below top of ground.
 - (4) casing plastic (material) bottom (depth)
 - (5) screen 18 (length) 179 (depth to top)
 - (6) pump 4" (size) plastic (material)
 - (7) pump 3/4 (HP) 37 (yield gpm)
 - (8) electric log no (yes or no)

(organization running log)

(8) how well bottom plugged back wash

DRILLERS REMARKS: none


DEPT. OF NATURAL RESOURCES
 BUREAU OF LAND & WATER RESOURCES

SEP 28 1983

RECEIVED

If well telescopes please sketch and show depths.

GROUND LEVEL

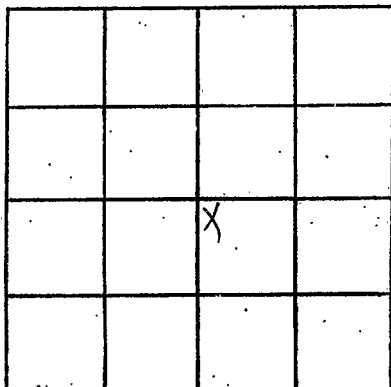

SECTION 36

Please indicate well location X.

ADDITIONAL INFORMATION

If more than one screen, show locations of each on sketch.