

MISSISSIPPI DEPARTMENT OF NATURAL RESOURCES

Bureau of Land and Water Resources

Southport Mall

P.O. Box 10631

Jackson, Mississippi 39209

WATER WELL DRILLERS LOG

PIKE
D 2048

12-5
date well completed

19 83

Itz...
firm name

Pike
county well located

LANDOWNER:	description of formations encountered	from	to
<u>Clinton Moore</u>			
<u>R.R. Submittion</u> (mailing address)	<u>Red Clay</u> <u>Red Sand</u> <u>Coarse Sand & gravel</u>	<u>0</u> <u>20</u> <u>110</u>	<u>20</u> <u>110</u> <u>120</u>
<p>WELL LOCATION:</p> <p>sec. <u>6</u> T. <u>3</u> N. R. <u>2</u> E</p> <p><u>5</u> miles <u>WSW</u> of <u>Sumit</u></p> <p>(distance) (direction) (nearest town)</p>			
<p>WELL PURPOSE: <u>Home</u></p> <p>(home, irrigation, municipal, industrial)</p>			
<p>WELL COMPLETION DATA:</p> <p>(1) diameter (inches) <u>4</u></p> <p>(2) total depth (feet) <u>120</u></p> <p>(3) static water level (feet) <u>60</u> below top of ground.</p> <p>(4) casing <u>PVC, 112</u> (material) (depth)</p> <p><u>4</u> if telescope see back. (size)</p> <p>(5) screen <u>8</u>, <u>112</u> (length) (depth to top)</p> <p><u>4</u>, <u>PVC</u> (size) (material)</p> <p>(6) pump <u>1/2</u>, <u>10</u> (HP) (yield gpm)</p> <p><u>che</u> (type power)</p> <p>(7) electric log <u>No</u> (yes or no)</p> <p>(organization running log)</p> <p>(8) how well bottom plugged <u>Sealed</u></p>			

DEPT. OF NATURAL RESOURCES
BUREAU OF LAND & WATER RESOURCES


DEC - 9 1983

RECEIVED

DRILLERS REMARKS:

If well telescopes please
sketch and show depths.

GROUND LEVEL

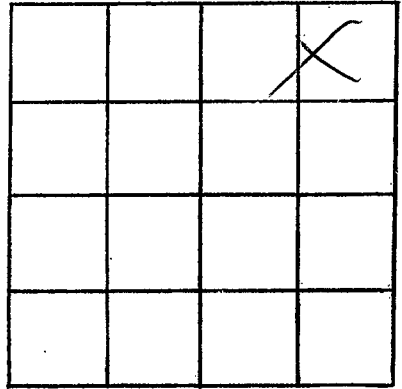

SECTION 6

Please indicate well location X.

ADDITIONAL INFORMATION

If more than one screen,
show locations of each on sketch.