

MISSISSIPPI DEPARTMENT OF NATURAL RESOURCES

Bureau of Land and Water Resources

Southport Mall

P.O. Box 10631

Jackson, Mississippi 39209

WATER WELL DRILLERS LOG

*Pike*  
D 2050

2-13

1984

*Howard S. Pike*

*Pike*

date well completed

firm name

county well located

LANDOWNER:

*Mark Stalton*

*R.D. McComb, Jr.*  
(mailing address)

description of formations encountered

from

to

<i>Red clay</i>	0	20
<i>Red sand</i>	20	100
<i>Coarse sand &amp; gravel</i>	100	110

WELL LOCATION:

sec. 19 T 3 N R 7 E  
S W  
5 miles W of McComb  
(distance) (direction) (nearest town)

WELL PURPOSE:

*Home*  
(home, irrigation, municipal, industrial)

WELL COMPLETION DATA:

- (1) diameter (inches) 4
- (2) total depth (feet) 110
- (3) static water level (feet) 75 below above top of ground.
- (4) casing PVC, 102,  
(material) (depth)  
4 if telescope see back.  
(size)
- (5) screen 8, 102  
(length) (depth to top)  
4, PVC  
(size) (material)
- (6) pump 1/2, 70  
(HP) (yield gpm)  
electric  
(type power)
- (7) electric log yes  
(yes or no)  
McComb  
(organization running log)
- (8) how well bottom plugged Sealed

DRILLERS REMARKS:


DEPT. OF NATURAL RESOURCES  
BUREAU OF LAND & WATER RESOURCES

MAR - 7 1984

RECEIVED

If well telescopes please sketch and show depths.

GROUND LEVEL

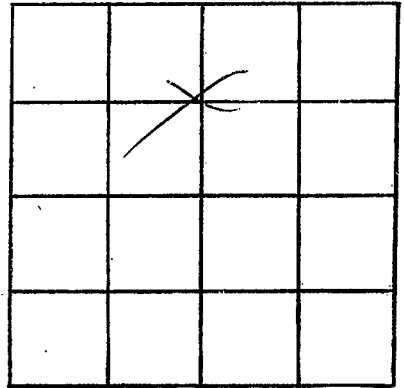

SECTION 19

Please indicate well location X.

ADDITIONAL INFORMATION

If more than one screen,  
show locations of each on sketch.