

MISSISSIPPI DEPARTMENT OF NATURAL RESOURCES

Bureau of Land and Water Resources

Southport Mall

P.O. Box 10631

Jackson, Mississippi 39209

WATER WELL DRILLERS LOG

Pike
D
2052

7-17 1984 J. H. Wallwell, Inc. Pike
 date well completed firm name county well located


LANDOWNER:	description of formations encountered	from	to
<u>James Burns</u> <u>B.R. McComb, ms.</u> (mailing address)	<u>Red clay</u> <u>Red sand</u> <u>Coarse sand & gravel</u>	<u>0</u> <u>20</u> <u>90</u>	<u>20</u> <u>90</u> <u>101</u>
<p>WELL LOCATION:</p> <p>sec. <u>17</u> T <u>3</u> N R <u>7</u> E S W</p> <p><u>2</u> miles <u>W</u> of <u>McComb</u> (distance) (direction) (nearest town)</p>			
<p>WELL PURPOSE: <u>Home</u> (home, irrigation, municipal, industrial)</p>			
<p>WELL COMPLETION DATA:</p> <p>(1) diameter (inches) <u>4</u></p> <p>(2) total depth (feet) <u>101</u></p> <p>(3) static water level (feet) <u>60</u> below above top of ground.</p> <p>(4) casing <u>PVC</u>, <u>93</u> (material) (depth) <u>4</u> if telescope see back. (size)</p> <p>(5) screen <u>8</u>, <u>93</u> (length) (depth to top) <u>4</u>, <u>PVC</u> (size) (material)</p> <p>(6) pump <u>1/2</u>, <u>10</u> (HP) (yield gpm) <u>Electric</u> (type power)</p> <p>(7) electric log <u>No</u> (yes or no) (organization running log)</p> <p>(8) how well bottom plugged <u>Sand block</u></p>			
<p>DRILLERS REMARKS:</p>			

DEPT. OF NATURAL RESOURCES
 BUREAU OF LAND & WATER RESOURCES

AUG 23 1984
 RECEIVED

If well telescopes please
sketch and show depths.

GROUND LEVEL

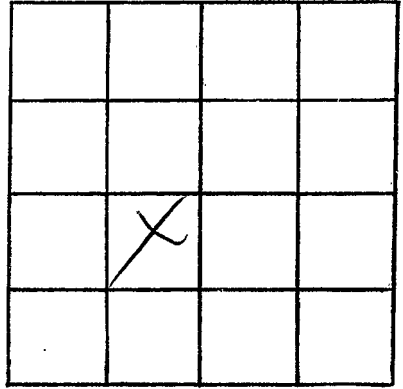

SECTION 17

Please indicate well location X.

ADDITIONAL INFORMATION

If more than one screen,
show locations of each on sketch.