

MISSISSIPPI DEPARTMENT OF NATURAL RESOURCES

Bureau of Land and Water Resources

Southport Mall

P.O. Box 10631

Jackson, Mississippi 39209

WATER WELL DRILLERS LOG

PIKE
D 2053

10-24 1984
date well completed

Fitzgerald Well Serv
firm name

Pike
county well located

LANDOWNER:	description of formations encountered	from	to
<u>Bobby M Daniel</u> <u>RR-1 McComb, ms.</u> (mailing address)	<u>Red clay</u> <u>Red sand</u> <u>Coarse sand & gravel</u>	<u>0</u> <u>20</u> <u>70</u>	<u>20</u> <u>70</u> <u>85</u>
WELL LOCATION: sec. <u>17</u> T. <u>3</u> N R. <u>7</u> E S W <u>2</u> miles <u>W</u> of <u>McComb</u> (distance) (direction) (nearest town)			
WELL PURPOSE: <u>Home</u> (home, irrigation, municipal, industrial)			
WELL COMPLETION DATA: (1) diameter (inches) <u>4</u> (2) total depth (feet) <u>85</u> (3) static water level (feet) <u>40</u> below above- top of ground. (4) casing <u>PVC</u> , <u>77</u> , (material) (depth) <u>4</u> if telescope see back. (size) (5) screen <u>8</u> , <u>77</u> (length) (depth to top) <u>4</u> , <u>PVC</u> (size) (material) (6) pump <u>1/2</u> , <u>10</u> (HP) (yield gpm) <u>el</u> (type power) (7) electric log <u>no</u> (yes or no) (organization running log) (8) how well bottom plugged <u>well</u>			
DRILLERS REMARKS:			


DEPT. OF NATURAL RESOURCES
BUREAU OF LAND & WATER RESOURCES

DEC -4 1984

RECEIVED

If well telescopes please
sketch and show depths.

GROUND LEVEL

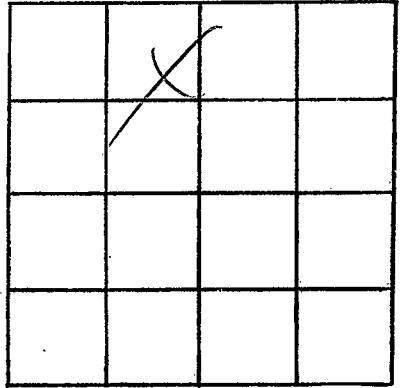

SECTION *17*

Please indicate well location X.

ADDITIONAL INFORMATION

If more than one screen,
show locations of each on sketch.