

MISSISSIPPI DEPARTMENT OF NATURAL RESOURCES

Bureau of Land and Water Resources

Southport Mall

P.O. Box 10631

Jackson, Mississippi 39209

WATER WELL DRILLERS LOG

PIKE
D 2054

12-31 1984
date well completed

St. Howell well Co
firm name

Pike
county well located

LANDOWNER:

Bill Rogers
Rob. Hunt, Jr.
212
(mailing address)

description of formations encountered

from

to

<u>Red clay</u>	<u>0</u>	<u>26</u>
<u>Red sandstone</u>	<u>16</u>	<u>28</u>
<u>white clay</u>	<u>25</u>	<u>45</u>
<u>Coarse sand & gravel</u>	<u>45</u>	<u>60</u>

WELL LOCATION:

sec. 12 T. 3 N R. 7 E
S W
3 miles west of Marble
(distance) (direction) (nearest town)

WELL PURPOSE:

(home, irrigation, municipal, industrial)

WELL COMPLETION DATA:


- (1) diameter (inches) 4
- (2) total depth (feet) 60
- (3) static water level (feet) 20 below top of ground.
- (4) casing PVC, 50,
(material) (depth)
4 if telescope see back.
(size)
- (5) screen 10, 50
(length) (depth to top)
4, PVC
(size) (material)
- (6) pump 1/2, 10
(HP) (yield gpm)
EL
(type power)
- (7) electric log no
(yes or no)
(organization running log)
- (8) how well bottom plugged full

0 6/10
1-7-82

DRILLERS REMARKS:

If well telescopes please sketch and show depths.

GROUND LEVEL

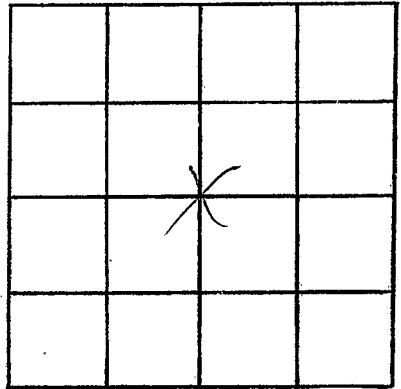

SECTION 17

Please indicate well location X.

ADDITIONAL INFORMATION

If more than one screen,
show locations of each on sketch.