

Pike
D 2055
6-7-85

MISSISSIPPI DEPARTMENT OF NATURAL RESOURCES
Bureau of Land and Water Resources
Southport Mall
P.O. Box 10631
Jackson, Mississippi 39209
WATER WELL DRILLERS LOG

L

6-7 1985 *Fitzgerald Well Serv* Pike
date well completed firm name county well located

LANDOWNER:
David Lee
Dr. McComb, Jr.
(mailing address)

description of formations encountered	from	to
<u>Red clay</u>	<u>0</u>	<u>20</u>
<u>Red sand</u>	<u>20</u>	<u>50</u>
<u>Cross sand gravel</u>	<u>50</u>	<u>95</u>

WELL LOCATION:
sec. 23 T. 3 N. R. 7 E
1/4 miles W of McComb
(distance) (direction) (nearest town)

WELL PURPOSE: Home
(home, irrigation, municipal, industrial)


- WELL COMPLETION DATA:
- (1) diameter (inches) 4
 - (2) total depth (feet) 95
 - (3) static water level (feet) 40 below above top of ground.
 - (4) casing 4 85
(material) (depth)
4 if telescope see back.
(size)
 - (5) screen 10 85
(length) (depth to top)
4 40C
(size) (material)
 - (6) pump 1/2 10
(HP) (yield gpm)
Electric
(type power)
 - (7) electric log No
(yes or no)
(organization running log)
 - (8) how well bottom plugged Sand fill

DRILLERS REMARKS:

RECEIVED
JUL 22 1985
Department of Natural Resources
Bureau of Land & Water Resources

If well telescopes please sketch and show depths.

GROUND LEVEL

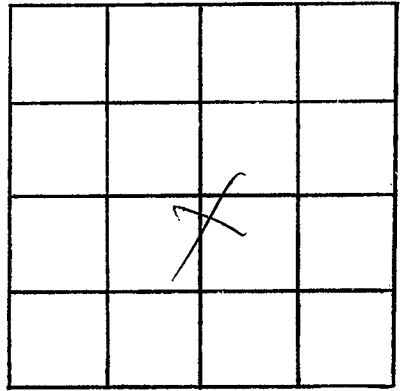

SECTION 23

Please indicate well location X.

ADDITIONAL INFORMATION

If more than one screen,
show locations of each on sketch.