

MISSISSIPPI DEPARTMENT OF NATURAL RESOURCES

Bureau of Land and Water Resources

Southport Mall

P.O. Box 10631

Jackson, Mississippi 39209

WATER WELL DRILLERS LOG

PILE
D 2058

9-25-86
date well completed

P. General Well Sew
firm name

Pike
county well located

LANDOWNER: *Randy Smith*
P.O. Box Farmwood Ms.
(mailing address)

description of formations encountered	from	to
<i>Real clay</i>	<i>0</i>	<i>20</i>
<i>Real sand</i>	<i>20</i>	<i>100</i>
<i>Coarse screened sand</i>	<i>100</i>	<i>114</i>

WELL LOCATION:
sec. *25* T-*3*N R-*2*E
S W
1/2 miles *W* of *Farmwood*
(distance) (direction) (nearest town)

WELL PURPOSE: *Home*
(home, irrigation, municipal, industrial)

WELL COMPLETION DATA:

(1) diameter (inches) *4*

(2) total depth (feet) *114*

(3) static water level (feet) *80* below top of ground.

(4) casing *PVC 104*
(material) (depth)
4 if telescope see back.
(size)

(5) screen *10 104*
(length) (depth to top)
4 *PVC*
(size) (material)

(6) pump *3/4 15*
(HP) (yield gpm)
elec
(type power)

(7) electric log *no*
(yes or no)
(organization running log)

(8) how well bottom plugged *Sealed*

RECEIVED


OCT 14 1986

Department of Natural Resources
Bureau of Land & Water Resources

DRILLERS REMARKS:

If well telescopes please sketch and show depths.

GROUND LEVEL

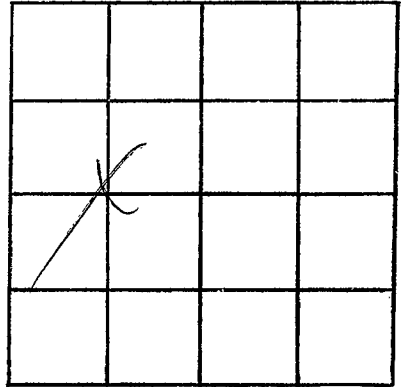

SECTION 25

Please indicate well location X.

ADDITIONAL INFORMATION

If more than one screen,
show locations of each on sketch.