

Pike
D 2060

MISSISSIPPI DEPARTMENT OF NATURAL RESOURCES
Bureau of Land and Water Resources
Southport Mall
P.O. Box 10631
Jackson, Mississippi 39209
WATER WELL DRILLERS LOG

3-16 1987 Fitzwell well Sew Pike
date well completed firm name county well located

LANDOWNER:
Sandy Landlife
Rt. 3, McComb, Miss.
(mailing address)

description of formations encountered	from	to
	<u>Red clay</u>	<u>2</u>
<u>Red sand & gravel</u>	<u>20</u>	<u>80</u>
<u>Coarse sand & gravel</u>	<u>80</u>	<u>95</u>

WELL LOCATION:
sec. 23 T 3 N R 7 E
 S W
1 miles W of McComb
(distance) (direction) (nearest town)

WELL PURPOSE: 16
(home, irrigation, municipal, industrial)

- WELL COMPLETION DATA:
- (1) diameter (inches) 4
 - (2) total depth (feet) 95
 - (3) static water level (feet) 35 below above top of ground.
 - (4) casing PVC 85
 (material) (depth)
 (size) if telescope see back.
 - (5) screen 10 85
 (length) (depth to top)
 (size) (material)
 - (6) pump 1/2 10
 (HP) (yield gpm)
 Elm
 (type power)
 - (7) electric log no
 (yes or no)
 (organization running log)
 - (8) how well bottom plugged Seal

RECEIVED


MAR 20 1987

Department of Natural Resources
Bureau of Land & Water Resources

DRILLERS REMARKS:

If well telescopes please sketch and show depths.

GROUND LEVEL

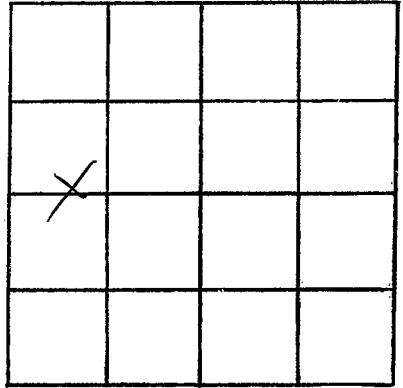

SECTION 23

Please indicate well location X.

ADDITIONAL INFORMATION

If more than one screen,
show locations of each on sketch.