

**MISSISSIPPI DEPARTMENT OF NATURAL RESOURCES**  
Bureau of Land and Water Resources

P.O. Box 10631

Jackson, Mississippi 39209

**WATER WELL DRILLERS LOG**

COUNTY WELL LOCATED <i>Pike</i>		PERMIT NUMBER
WELL NUMBER <i>D</i>	CODED	
DATE WELL COMPLETED <i>2065</i> <i>8-11-88</i>		NAME OF DRILLING FIRM <i>Browns Water Well</i> <i>RT 2 McComb</i>

NAME & MAILING ADDRESS OF LANDOWNER <i>Aug Stogorn</i> <i>RT 3 Box 157-A</i> <i>Summit, Ms 39666</i>			
WELL LOCATION: SEC	TOWNSHIP	RANGE	
<i>7</i>	<i>3</i>	<i>N</i>	<i>7</i>
		<i>S</i>	<i>W</i>
DISTANCE	DIRECTION	NEAREST TOWN	
<i>5</i> Miles	<i>West</i>	<i>McComb</i>	
OTHER LANDMARK			
WELL PURPOSE <input checked="" type="checkbox"/> Home Irrigation, Municipal, Industrial, Fish Pond, etc.			

<b>PUMP DATA</b>			
PUMP TYPE (Circle One): <input checked="" type="checkbox"/> Submersible Turbine, Jet Flowing Well, Other (Describe) _____			
POWER TYPE (Circle One): <input checked="" type="checkbox"/> Electric Tractor, Diesel, Gasoline, Butane, Other (Describe) _____			
Pump Capacity (GPM)	No. of Stages	Setting Depth	
<i>15</i>	<i>8</i>	<i>63</i> FT.	
PUMP TEST			
Well yielded <i>15</i> GPM with a drawdown of <i>10</i> ft. after <i>12</i> hours of pumping			

<b>WELL DATA</b>		
Well Depth <i>67</i>	Casing Diameter (In.) <i>4</i>	Casing Length (Ft.) <i>68</i>
Type of Casing <i>Plastic</i>	Hole Depth <i>67</i>	Depth to Static Water Level <i>30</i>
TYPE OF COMPLETION: (Circle One or More): <input checked="" type="checkbox"/> Gravel Packed, <input type="checkbox"/> Underreamed, <input type="checkbox"/> Telescoped, <input checked="" type="checkbox"/> Natural Development, <input type="checkbox"/> Open Hole, <input type="checkbox"/> Other		
Top of Lap Pipe or Reduction in Casing		
FEET		
IF TELESCOPED OR MORE THAN ONE SCREEN: USE BACK PAGE		

<b>LOG DATA</b>	
TYPE OF LOG RUN (Circle One): <input checked="" type="checkbox"/> No Log Run, Electric, Gamma Ray, Density, Sonic, Neutron, Other (Describe) _____	
Name of Organization Running Log	

<b>SCREEN DATA</b>		
Diameter - Inches <i>4</i>	Length - Feet <i>10</i>	Slot Size - Inches <i>012</i>
Screen Type <i>plastic</i>	Depth to Bottom - Feet <i>68</i>	


<b>GEOLOGIC DATA (Office Use Only)</b>			
Surface Elev.	Geologic Unit	Unit Thickness	Depth to Top
Subs. SWL	Date	Analysis	Aquifer Test
Driller's Remarks			

DESCRIPTION OF FORMATIONS ENCOUNTERED	FROM	TO	FORMATIONS (Continued)	FROM	TO
<i>Top Soil</i>	<i>0</i>	<i>1</i>			
<i>Brown Clay</i>	<i>1</i>	<i>5</i>			
<i>Brown Clay + GRAVEL</i>	<i>5</i>	<i>25</i>			
<i>White Clay</i>	<i>25</i>	<i>37</i>			
<i>Sand + gravel</i>	<i>37</i>	<i>67</i>			

IF MORE SPACE IS NEEDED, USE BACK

If well telescopes please sketch and show depths.

GROUND LEVEL

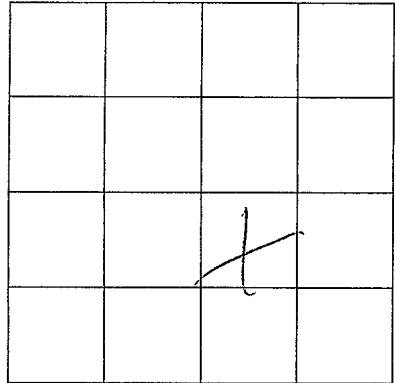

SECTION 7

Please indicate well location X.

ADDITIONAL INFORMATION

If more than one screen,  
show location of each on sketch.