

**MISSISSIPPI DEPARTMENT OF NATURAL RESOURCES**  
Bureau of Land and Water Resources

P.O. Box 10631  
Jackson, Mississippi 39209  
WATER WELL DRILLERS LOG

COUNTY WELL LOCATED <i>Dike</i>		
WELL NUMBER <i>D</i>	CODED	PERMIT NUMBER
DATE WELL COMPLETED <i>2070</i> <i>July 7 1988</i>		NAME OF DRILLING FIRM <i>Boons Water Well</i> <i>McComb, MS 39648</i>

NAME & MAILING ADDRESS OF LANDOWNER  
*Marie Crowe*  
*P.O. Box 913*  
*McComb, MS. 39648*

WELL LOCATION: SEC *7* TOWNSHIP *3 S* RANGE *7 W*

DISTANCE *6* Miles *West* of *McComb*

DIRECTION

NEAREST TOWN

OTHER LANDMARK  
*Cemetery Right Across Road*

WELL PURPOSE:  Home  Irrigation, Municipal, Industrial, Fish Pond, etc.

**PUMP DATA**

PUMP TYPE (Circle One):  
Submersible, Turbine, Jet, Flowing Well,  
Other (Describe) \_\_\_\_\_

POWER TYPE (Circle One):  
Electric, Tractor, Diesel, Gasoline, Butane,  
Other (Describe) \_\_\_\_\_

Pump Capacity (GPM) <i>30</i>	No. of Stages <i>9</i>	Setting Depth <i>90</i> FT.
----------------------------------	---------------------------	--------------------------------

PUMP TEST

Well yielded *30* GPM with  
a drawdown of *18* ft.  
after *5* hours of pumping

**WELL DATA**

Well Depth <i>152</i>	Casing Diameter (In.) <i>4</i>	Casing Length (Ft.) <i>152 1/2</i>
Type of Casing <i>plastic</i>	Hole Depth <i>152</i>	Depth to Static Water Level <i>52</i>

TYPE OF COMPLETION: (Circle One or More):  
 Gravel Packed,  Underreamed,  Telescoped,  
 Natural Development,  Open Hole,  Other  
(Describe) \_\_\_\_\_

Top of Lap Pipe or Reduction in Casing  
FEET IF TELESCOPED OR MORE THAN ONE SCREEN: USE BACK PAGE

**LOG DATA**

TYPE OF LOG RUN (Circle One):  
No Log Run, Electric, Gamma Ray, Density, Sonic, Neutron,  
Other (Describe) \_\_\_\_\_

Name of Organization Running Log

**SCREEN DATA**

Diameter - Inches <i>4</i>	Length - Feet <i>10</i>	Slot Size - Inches <i>012</i>
Screen Type <i>plastic</i>	Depth to Bottom - Feet <i>152 1/2</i>	

**GEOLOGIC DATA (Office Use Only)**

Surface Elev.	Geologic Unit	Unit Thickness	Depth to Top
Subs. SWL	Date	Analysis	Aquifer Test

Driller's Remarks  
*AUG 10 1988*


Department of Natural Resources  
Bureau of Land & Water Resources

DESCRIPTION OF FORMATIONS ENCOUNTERED	FROM	TO	FORMATIONS (Continued)	FROM	TO
<i>Top Soil</i>	<i>0</i>	<i>1</i>	<i>White Clay</i>	<i>60</i>	<i>80</i>
<i>Red Sand</i>	<i>1</i>	<i>6</i>	<i>Blue Clay</i>	<i>80</i>	<i>105</i>
<i>Red Clay gravel</i>	<i>6</i>	<i>25</i>	<i>COURSE SAND &amp; GRAVEL</i>	<i>105</i>	<i>152</i>
<i>Red Sand</i>	<i>25</i>	<i>37</i>			
<i>Red clay</i>	<i>37</i>	<i>45</i>			
<i>SAND &amp; GRAVEL</i>	<i>45</i>	<i>60</i>			

IF MORE SPACE IS NEEDED, USE BACK

If well telescopes please sketch and show depths.

GROUND LEVEL

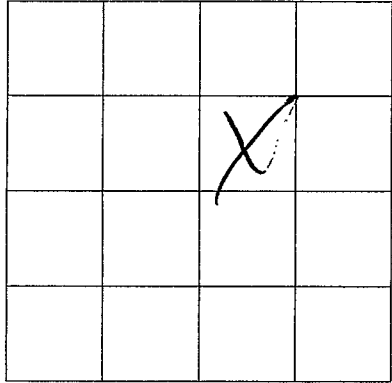

SECTION 7

Please indicate well location X.

ADDITIONAL INFORMATION

If more than one screen,  
show location of each on sketch.