

MISSISSIPPI DEPARTMENT OF NATURAL RESOURCES
Bureau of Land and Water Resources

P.O. Box 10631
Jackson, Mississippi 39209
WATER WELL DRILLERS LOG

COUNTY WELL LOCATED <i>Pike</i>	
WELL NUMBER <i>D</i>	CODED
DATE WELL COMPLETED <i>2072</i> <i>12-15-89</i>	

PERMIT NUMBER
NAME OF DRILLING FIRM <i>FITZGERALD Well Serv</i>

NAME & MAILING ADDRESS OF LANDOWNER <i>Jerry Tuenge</i> <i>H.R. McComb, Jr.</i>		
WELL LOCATION: SEC	TOWNSHIP	RANGE
<i>23</i>	<i>3</i>	<i>N 7 E</i>
DISTANCE	DIRECTION	NEAREST TOWN
<i>1</i> Miles	<i>SW</i> of	<i>McComb</i>
OTHER LANDMARK		
WELL PURPOSE: Home, Irrigation, Municipal, Industrial, Fish Pond, etc. <i>Home</i>		

PUMP DATA		
PUMP TYPE (Circle One): <input checked="" type="radio"/> Submersible <input type="radio"/> Turbine <input type="radio"/> Jet <input type="radio"/> Flowing Well, Other (Describe) _____		
POWER TYPE (Circle One): <input checked="" type="radio"/> Electric <input type="radio"/> Tractor <input type="radio"/> Diesel <input type="radio"/> Gasoline <input type="radio"/> Butane, Other (Describe) _____ H/P _____		
Pump Capacity (GPM) <i>10</i>	No. of Stages <i>9</i>	Setting Depth <i>100</i> FT.
PUMP TEST		
Well yielded <i>15</i> GPM with a drawdown of <i>3</i> ft. after <i>2</i> hours of pumping		


WELL DATA		
Well Depth <i>147</i>	Casing Diameter (In.) <i>4</i>	Casing Length (Ft.) <i>137</i>
Type of Casing <i>PVC</i>	Hole Depth <i>147</i>	Depth to Static Water Level <i>76</i>
TYPE OF COMPLETION: (Circle One or More): <input checked="" type="radio"/> Gravel Packed <input type="radio"/> Underreamed <input type="radio"/> Telescoped, <input checked="" type="radio"/> Natural Development <input type="radio"/> Open Hole <input type="radio"/> Other (Describe) _____		
Top of Lap Pipe or Reduction in Casing		
FEET <input type="checkbox"/> IF TELESCOPED OR MORE THAN ONE SCREEN: USE BACK PAGE		

LOG DATA			
TYPE OF LOG RUN (Circle One): Electric, Gamma Ray, Density, Sonic, <input checked="" type="radio"/> Neutron, Other (Describe) _____			
Name of Organization Running Log			

SCREEN DATA		
Diameter - Inches <i>4</i>	Length - Feet <i>10</i>	Slot Size - Inches <i>014</i>
Screen Type		Depth to Bottom - Feet


GEOLOGIC DATA (Office Use Only)			
Surface Elev.	Geologic Unit	Unit Thickness	Depth to Top
Subs. SWL	Date	Analysis	Aquifer Test

Driller's Remarks

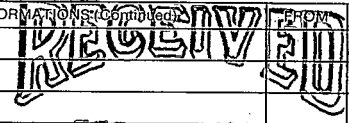DESCRIPTION OF FORMATIONS ENCOUNTERED	FROM	TO	FORMATIONS ENCOUNTERED FROM	TO
<i>Red Clay</i>	<i>0</i>	<i>20</i>	 FEB 15 1990 Department of Natural Resources Bureau of Land & Water Resources	
<i>Red Sand</i>	<i>20</i>	<i>70</i>		
<i>Red gravel</i>	<i>70</i>	<i>82</i>		
<i>Red white chalk</i>	<i>82</i>	<i>120</i>		
<i>Coarse Sand & gravel</i>	<i>120</i>	<i>137</i>		
IF MORE SPACE IS NEEDED, USE BACK				

If well telescopes please sketch and show depths.

GROUND LEVEL

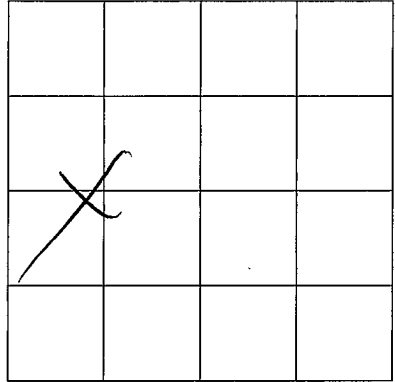

SECTION 23

Please indicate well location X.

ADDITIONAL INFORMATION

[Faint, illegible handwritten text]

If more than one screen,
show location of each on sketch.