

MISSISSIPPI DEPARTMENT OF ENVIRONMENTAL QUALITY

Office of Land and Water Resources

P. O. Box 10631
Jackson, MS 39289-0631
WATER WELL DRILLERS LOG

COUNTY WELL LOCATED <i>Pike</i>	
WELL NUMBER <i>D</i>	CODED
DATE WELL COMPLETED <i>2087</i> <i>October 13-93</i>	

PERMIT NUMBER
NAME OF DRILLING FIRM FITZGERALD <i>Well</i> <i>FITZGERALD SERV</i>

NAME & MAILING ADDRESS OF LANDOWNER <i>Bubba Traylor</i> <i>P.O. Box McComb, ms</i>			
WELL LOCATION:	SEC	TOWNSHIP	RANGE
	<i>10</i>	<i>3</i>	<i>N 7 E</i>
DISTANCE	DIRECTION	NEAREST TOWN	
<i>1M</i> Miles	<i>North</i>	of <i>McComb</i>	
OTHER LANDMARK			
WELL PURPOSE: Home, Irrigation, Municipal, Industrial, Fish Pond, etc. <i>YARD SPRINKLER</i>			

PUMP DATA			
PUMP TYPE (Circle One): <input checked="" type="radio"/> Submersible, Turbine, Jet, Flowing Well, Other (Describe) _____			
POWER TYPE (Circle One): <input checked="" type="radio"/> Electric, Tractor, Diesel, Gasoline, Butane, Other (Describe) _____ H/P <i>1</i>			
Pump Capacity (GPM)	No. of Stages	Setting Depth	
<i>20</i>	<i>10</i>	<i>90</i>	FT.
PUMP TEST			
Well yielded <i>40</i> GPM with a drawdown of <i>2</i> ft. after <i>2</i> hours of pumping			

WELL DATA		
Well Depth	Casing Diameter (in.)	Casing Length (Ft.)
<i>100</i>	<i>4</i>	<i>90</i>
Type of Casing	Hole Depth	Depth to Static Water Level
<i>PVC</i>	<i>100</i>	<i>68</i>
TYPE OF COMPLETION: (Circle One or More): <input checked="" type="checkbox"/> Gravel Packed, Underreamed, Telescoped, <input type="checkbox"/> Natural Development, <input type="checkbox"/> Open Hole, <input type="checkbox"/> Other (Describe) _____		

LOG DATA	
TYPE OF LOG RUN (Circle One): <input checked="" type="radio"/> No Log Run, Electric, Gamma Ray, Density, Sonic, Neutron, Other (Describe) _____	
Name of Organization Running Log	

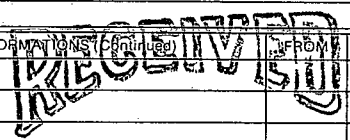
WELL GROUTED TO A DEPTH OF <i>10</i> FEET
Type Grout (circle one): Cement, Bentonite, or Mix

GEOLOGIC DATA (Office Use Only)			
Surface Elev.	Geologic Unit	Unit Thickness	Depth to Top
Subs. SWL	Date	Analysis	Aquifer Test

SCREEN DATA		
Diameter - Inches	Length - Feet	Slot Size - Inches
<i>4</i>	<i>10</i>	<i>1014</i>
Screen Type	Depth to Bottom - Feet	
<i>PVC</i>	<i>100</i>	

Driller's Remarks

DESCRIPTION OF FORMATIONS ENCOUNTERED	FROM	TO
<i>Red Clay</i>	<i>0</i>	<i>20</i>
<i>Red Sand</i>	<i>20</i>	<i>52</i>
<i>Course Sand & Gravel</i>	<i>52</i>	<i>100</i>

FORMATIONS CONTINUED	FROM	TO
 JAN 05 1994		
Dept. of Environmental Quality Office of Land & Water Resources		
IF MORE SPACE IS NEEDED, USE BACK		

If well telescopes please sketch and show depths.

GROUND LEVEL

			X

SECTION 10

Please indicate well location X.

ADDITIONAL INFORMATION

If more than one screen,
show location of each on sketch.