

MISSISSIPPI DEPARTMENT OF ENVIRONMENTAL QUALITY

Office of Land and Water Resources

P. O. Box 10631
Jackson, MS 39289-0631
WATER WELL DRILLERS LOG

COUNTY WELL LOCATED PIKE	
WELL NUMBER D 2102	CODED
DATE WELL COMPLETED 9-3-97	

PERMIT NUMBER 0-287
NAME OF DRILLING FIRM REEVES WELL SERV.

NAME & MAILING ADDRESS OF LANDOWNER Jungo Harris			
WELL LOCATION: SEC 23 TOWNSHIP 3 RANGE 7			
DISTANCE 1/2 Miles DIRECTION W of NEAREST TOWN MRCOMB			
OTHER LANDMARK			
WELL PURPOSE: Home, Irrigation, Municipal, Industrial, Fish Pond, etc. HOME			

PUMP DATA		
PUMP TYPE (Circle One): Submersible , Turbine, Jet, Flowing Well, Other (Describe) _____		
POWER TYPE (Circle One): Electric , Tractor, Diesel, Gasoline, Butane, Other (Describe) _____ H/P 12		
Pump Capacity (GPM) 10	No. of Stages 8	Setting Depth 90 FT.
PUMP TEST		
Well yielded 50 GPM with a drawdown of 0 ft. after 1 hours of pumping		

WELL DATA		
Well Depth 100	Casing Diameter (In.) 4"	Casing Length (Ft.) 20'
Type of Casing PVC	Hole Depth 100	Depth to Static Water Level 70'
TYPE OF COMPLETION: (Circle One or More): Gravel Packed, Underreamed, Telescoped, Natural Development, Open Hole, Other (Describe) 10 GAL SAND		
WELL GROUTED TO A DEPTH OF 10 FEET Type Grout (circle one): REMENT , Bentonite, or Mix		

LOG DATA	
TYPE OF LOG RUN (Circle One): No Log Run, Electric, Gamma Ray, Density, Sonic, Neutron, Other (Describe) _____	
Name of Organization Running Log	

SCREEN DATA		
Diameter - Inches 4"	Length - Feet 10'	Slot Size - Inches 10 THDS.
Screen Type PVC	Depth to Bottom - Feet 100	

GEOLOGIC DATA (Office Use Only)			
Surface Elev.	Geologic Unit	Unit Thickness	Depth to Top
Subs. SWL	Date	Analysis	Aquifer Test
Driller's Remarks			
Top of Lap Pipe or Reduction in Casing			
FEET IF TELESCOPED OR MORE THAN ONE SCREEN: USE BACK PAGE			

DESCRIPTION OF FORMATIONS ENCOUNTERED	FROM	TO	FORMATIONS (Continued)	FROM	TO
CLAY	0	15-			
SAND & GRAVEL	15	75-			
RED CHALK	75	85-			
SAND & GRAVEL	85	100			

RECEIVED


SEP 23 1997

Dept. of Environmental Quality
Office of Land & Water Resources

IF MORE SPACE IS NEEDED, USE BACK

If well telescopes please sketch and show depths.

GROUND LEVEL

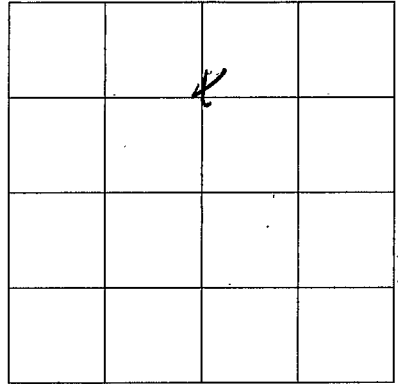

SECTION 23

Please indicate well location X.

ADDITIONAL INFORMATION

If more than one screen,
show location of each on sketch.