
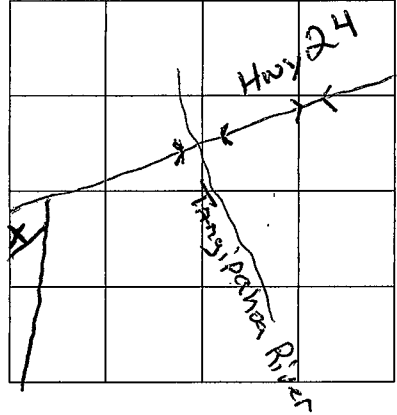


If well telescopes please sketch and show depths.

GROUND LEVEL

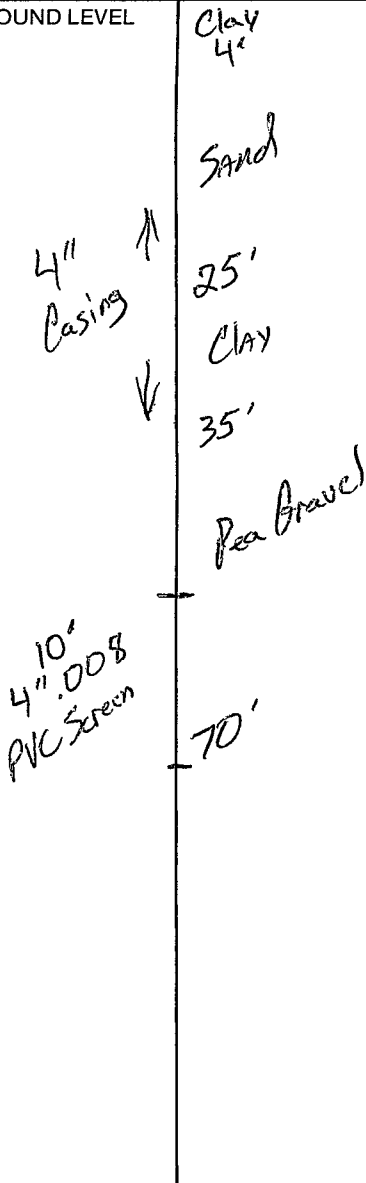

SECTION 20

Please indicate well location X.

ADDITIONAL INFORMATION

go 3 miles west of
Malcomb on Hwy 24, cross
River Take next left on
Irene rd. then take first
right on Horseshoe Dr, first
residents on right

If more than one screen,
show location of each on sketch.