

MISSISSIPPI DEPARTMENT OF ENVIRONMENTAL QUALITY

Office of Land and Water Resources

P. O. Box 10631
Jackson, MS 39289-0631
WATER WELL DRILLERS LOG

COUNTY WELL LOCATED <i>Pike</i>	
WELL NUMBER <i>DZ192</i>	CODED
DATE WELL COMPLETED <i>10-23-98</i>	

PERMIT NUMBER <i>0-287</i>
NAME OF DRILLING FIRM <i>Keeves Well Ser.</i>

NAME & MAILING ADDRESS OF LANDOWNER <i>Gregory Fortenberry</i>			
WELL LOCATION: SEC <u>5</u> TOWNSHIP <u>3</u> RANGE <u>7</u> <u>(E)</u> <u>(W)</u>			
DISTANCE <u>2</u> Miles	DIRECTION <u>NW</u>	NEAREST TOWN <u>McComb</u>	
OTHER LANDMARK			
WELL PURPOSE: Home, Irrigation, Municipal, Industrial, Fish Pond, etc. <u> </u>			

PUMP DATA		
PUMP TYPE (Circle One): Submersible, Turbine, Jet, Flowing Well, Other (Describe) _____		
POWER TYPE (Circle One): Electric, Tractor, Diesel, Gasoline, Butane, Other (Describe) _____ H/P _____		
Pump Capacity (GPM)	No. of Stages	Setting Depth FT.
PUMP TEST		
Well yielded <u>40</u> GPM with a drawdown of <u>0</u> ft. after <u>1</u> hours of pumping		

WELL DATA		
Well Depth <u>85'</u>	Casing Diameter (In.) <u>4"</u>	Casing Length (Ft.) <u>20'</u>
Type of Casing <u>PVC</u>	Hole Depth <u>85'</u>	Depth to Static Water Level <u>50'</u>
TYPE OF COMPLETION: (Circle One or More): Gravel Packed, Underreamed, Telescoped, Natural Development, Open Hole, Other (Describe) <u>10 gal. sand</u>		
WELL GROUTED TO A DEPTH OF <u>10</u> FEET Type Grout (circle one): <u>Cement</u> , Bentonite, or Mix		

LOG DATA	
TYPE OF LOG RUN (Circle One): Electric, Gamma Ray, Density, Sonic, Neutron, Other (Describe) _____	
Name of Organization Running Log _____	

SCREEN DATA		
Diameter - Inches <u>4"</u>	Length - Feet <u>10'</u>	Slot Size - Inches <u>10 Std.</u>
Screen Type <u>PVC</u>	Depth to Bottom - Feet <u>85'</u>	

GEOLOGIC DATA (Office Use Only)			
Surface Elev.	Geologic Unit	Unit Thickness	Depth to Top
Subs. SWL	Date	Analysis	Aquifer Test
Driller's Remarks _____			
Top of Lap Pipe or Reduction in Casing FEET <input type="checkbox"/> IF TELESCOPED OR MORE THAN ONE SCREEN: USE BACK PAGE			

DESCRIPTION OF FORMATIONS ENCOUNTERED	FROM	TO
<i>clay</i>	<i>0</i>	<i>15</i>
<i>sand & gravel</i>	<i>15</i>	<i>55</i>
<i>clay</i>	<i>55</i>	<i>70</i>
<i>sand & gravel</i>	<i>70</i>	<i>85</i>

FORMATIONS (Continued)	FROM	TO
RECEIVED		
JUN 28 1999		
Dept of Environmental Quality Office of Land & Water Resources		
IF MORE SPACE IS NEEDED, USE BACK		

If well telescopes please sketch and show depths.


GROUND LEVEL

	A		

SECTION 5

Please indicate well location X.

ADDITIONAL INFORMATION

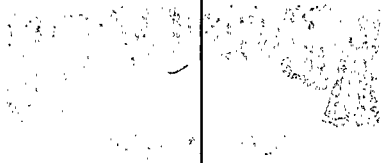

If more than one screen,
show location of each on sketch.