


 
MISSISSIPPI DEPARTMENT OF ENVIRONMENTAL QUALITY
Office of Land and Water Resources

P. O. Box 10631
Jackson, MS 39289-0631
WATER WELL DRILLERS LOG

COUNTY WELL LOCATED <u>Pike</u>	
WELL NUMBER <u>D-2196</u>	CODED
DATE WELL COMPLETED <u>5-9-00</u>	

113

PERMIT NUMBER <u>0-621</u>
NAME OF DRILLING FIRM <u>Daniel Boone</u>

NAME & MAILING ADDRESS OF LANDOWNER <u>Mary Adams</u>			
<u>1167 C Magnolia Pisgah</u>			
<u>Summitt, MS.</u>			
WELL LOCATION	SEC	TOWNSHIP	RANGE
	<u>8</u>	<u>3</u> 	<u>2</u> 
DISTANCE	DIRECTION	NEAREST TOWN	
<u>2 1/2</u> Miles	<u>W</u>	of <u>McComb</u>	
OTHER LANDMARK			
WELL PURPOSE: <input checked="" type="checkbox"/> Home Irrigation; <input type="checkbox"/> Municipal; <input type="checkbox"/> Industrial; <input type="checkbox"/> Fish Pond, etc.			

PUMP DATA		
PUMP TYPE (Circle One): <input checked="" type="checkbox"/> Submersible; <input type="checkbox"/> Turbine; <input type="checkbox"/> Jet; <input type="checkbox"/> Flowing-Well; Other (Describe)		
POWER TYPE (Circle One): <input checked="" type="checkbox"/> Electric; <input type="checkbox"/> Tractor; <input type="checkbox"/> Diesel; <input type="checkbox"/> Gasoline; <input type="checkbox"/> Butane; Other (Describe) H/P <u>1</u>		
Pump Capacity (GPM): <u>12</u>	No. of Stages	Setting Depth <u>115</u> FT.
PUMP TEST		
Well yielded <u>18</u> GPM with		
a drawdown of <u>20</u> ft.		
after <u>10</u> hours of pumping		

WELL DATA		
Well Depth <u>145'</u>	Casing Diameter (In.) <u>4"</u>	Casing Length (Fl.) <u>125</u>
Type of Casing <u>PVC</u>	Hole Depth <u>145'</u>	Depth to Static Water Level <u>80'</u>
TYPE OF COMPLETION: (Circle One or More): <input checked="" type="checkbox"/> Gravel Packed; <input type="checkbox"/> Underreamed; <input type="checkbox"/> Telescoped; <input type="checkbox"/> Natural Development; <input type="checkbox"/> Open Hole; <input type="checkbox"/> Other (Describe)		
WELL GROUTED TO A DEPTH OF <u>10</u> FEET Type Grout (circle one): <input checked="" type="checkbox"/> Cement, <input type="checkbox"/> Bentonite, or Mix		

LOG DATA	
TYPE OF LOG RUN (Circle One): <input type="checkbox"/> Electric; <input type="checkbox"/> Gamma Ray; <input type="checkbox"/> Density; <input type="checkbox"/> Sonic; <input type="checkbox"/> Neutron; Other (Describe)	
Name of Organization Running Log <u>No Log Run</u>	

SCREEN DATA		
Diameter - Inches <u>4"</u>	Length - Feet <u>20'</u>	Slot Size - Inches <u>.008</u>
Screen Type <u>PVC Sch. 40</u>	Depth to Bottom - Feet <u>0</u>	


GEOLOGIC DATA (Office Use Only)			
Surface Elev.	Geologic Unit	Unit Thickness	Depth to Top
Subs. SWL	Date	Analysis	Aquifer Test
Driller's Remarks			
Top of Lap Pipe or Reduction in Casing <u>DEC 2000</u> IF TELESCOPED OR MORE THAN ONE SCREEN, USE BACK PAGE.			

DESCRIPTION OF FORMATIONS ENCOUNTERED	FROM	TO	FORMATIONS (Continued)	FROM	TO
			<u>AUG 04 2000</u>		
			Dept. of Environmental Quality Office of Land & Water Resources		
			<u>DEC 2000</u>		
			<u>MAR 23 2001</u>		
			Dept. of Environmental Quality Office of Land & Water Resources		

IF MORE SPACE IS NEEDED, USE BACK.

If well telescopes please sketch and show depths.

GROUND LEVEL

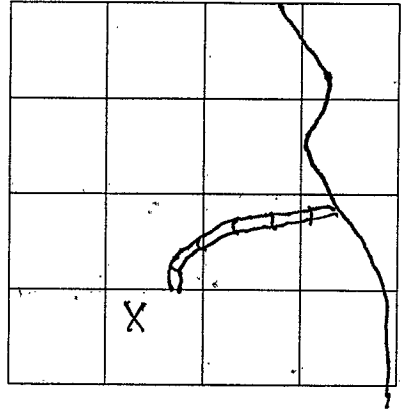

SECTION 8

Please indicate well location X.

ADDITIONAL INFORMATION

If more than one screen, show location of each on sketch.