

MISSISSIPPI DEPARTMENT OF ENVIRONMENTAL QUALITY
Office of Land and Water Resources

P. O. Box 10631
Jackson, MS 39289-0631
WATER WELL DRILLERS LOG

COUNTY WELL LOCATED <u>Pike</u>	
WELL NUMBER <u>D-9205</u>	CODED
DATE WELL COMPLETED <u>5-4-02</u>	

PERMIT NUMBER <u>0-621</u>
NAME OF DRILLING FIRM <u>Daniel Boone</u> <u>Tylertown, MS</u>

NAME & MAILING ADDRESS OF LANDOWNER <u>Gaby Dillon</u> <u>3093 Irene Rd</u> <u>Magnolia MS</u>			
Latitude: Longitude:			
WELL LOCATION:	SEC	TOWNSHIP	RANGE
	<u>31</u>	<u>3 N</u>	<u>7 E</u>
DISTANCE	DIRECTION	NEAREST TOWN	
<u>5</u> Miles	<u>SW</u>	of <u>McComb</u>	
OTHER LANDMARK			
WELL PURPOSE: <u>Home</u> Irrigation, Municipal, Industrial, Fish Pond, etc.			

PUMP DATA		
PUMP TYPE (Circle One): Submersible, Turbine, Jet, Flowing Well, Other (Describe) _____		
POWER TYPE (Circle One): Electric, Tractor, Diesel, Gasoline, Butane, Other (Describe) _____		
	H/P	<u>1</u>

DESCRIPTION OF FORMATIONS ENCOUNTERED	FROM	TO
<u>CLAY</u>	<u>0</u>	<u>28</u>
<u>Sand</u>	<u>28</u>	<u>92</u>
<u>Pea Gravel</u>	<u>92</u>	<u>138</u>

RECEIVED
MAY 20 2002
BY: OLWR

Top of Lap Pipe or Reduction in Casing FEET	IF TELESCOPED OR MORE THAN ONE SCREEN: USE BACK PAGE
---	--

WELL DATA

Well Depth <u>138</u>	Casing Diameter (In.) <u>4"</u>	Casing Length (Ft.) <u>128</u>
Type of Casing <u>PVC</u>	Hole Depth <u>138</u>	Depth to Static Water Level <u>75</u>

TYPE OF COMPLETION: (Circle One or More):
Gravel Packed, Underreamed, Telescoped,
Natural Development, Open Hole, Other (Describe)

WELL GROUTED TO A DEPTH OF 11 FEET
Type Grout (circle one): Cement, Bentonite, or Mix

SCREEN DATA

Diameter - Inches <u>4"</u>	Length - Feet <u>10'</u>	Slot Size - Inches <u>.010</u>
Screen Type <u>PVC Sch. 40</u>	Depth to Bottom - Feet <u>0</u>	


I certify that the well was drilled, constructed and completed in accordance with all applicable Requirements of the Mississippi Department of Environmental Quality and/or the Mississippi Department of Health regulations and state laws.

Daniel Boone 0-621
Signature of Licensed Driller and License No.

5-11-02
Date

If well telescopes please sketch and show depths.

GROUND LEVEL

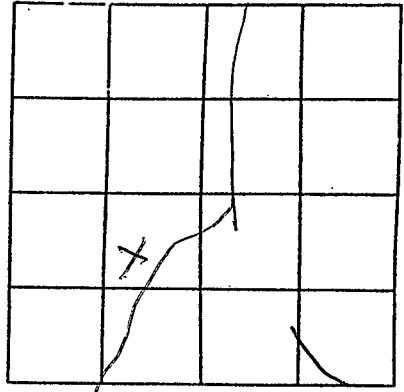

SECTION 31

Please indicate well location X.

Pump Capacity (GPM)	No. of Stages	Setting Depth
<u>12</u>		<u>100</u> FT.
PUMP TEST		
Well yielded <u>18</u> GPM with		
a drawdown of <u>15</u> ft.		
after <u>12</u> hours of pumping		

LOG DATA

TYPE OF LOG RUN (Circle One): No Log Run
Electric, Gamma Ray, Density, Sonic, Neutron,
Other (Describe) _____

Name of Organization Running Log

GEOLOGIC DATA (Office Use Only)

Surface Elev.	Geologic Unit	Unit Thickness	Depth to Top
Subs. SWL	Date	Analysis	Aquifer Test

Driller's Remarks

If more than one screen,
show location of each on sketch.