

**MISSISSIPPI
BOARD OF WATER COMMISSIONERS**
416 North State Street
Jackson, Mississippi 39201

WATER WELL DRILLERS LOG

Pike
E2
3-67 **CODED**
Elec Log 105

3-30 1967 Layner-Central Co. Pike
date well completed firm name county well located

LANDOWNER: Friendship
Community Water Assoc.
McComb, Miss
(mailing address)



description of formations encountered	from	to
Red Sandy Clay	0	19
Coarse Sand + gravel, streaks of clay	19	90
White Clay	90	175
Sand, silt, gravel + Clay	175	240
Clay	240	256
Sand, silt, clay	256	276
Hard Shell	276	496
Fine Sand, silt, of shale	496	519
Sand	519	610
Shale	610	614

WELL LOCATION:
sec. 5 T. 3 (N) R. B (E)
S W
3 miles East of McComb
(distance) (direction) (nearest town)

WELL PURPOSE: Domestic
(home, irrigation, municipal, industrial)

WELL COMPLETION DATA:

- (1) diameter (inches) 10"
- (2) total depth (feet) 614' 595
- (3) static water level (feet) 170' below above top of ground.
- (4) casing 10" (material) (depth)
 if telescope see back.
(size)
- (5) screen 60' 534' 8"
(length) (depth to top)
8" Stainless Steel
(size) (material)
- (6) pump 30 (HP) (yield gpm)
Electric
(type power)
- (7) electric log YES (yes or no)
MISS. GEOLOGICAL SURVEY
(organization running log)
- (8) how well bottom plugged Slugs

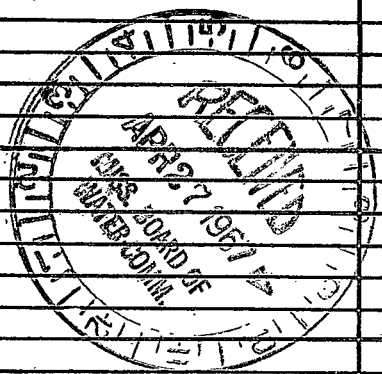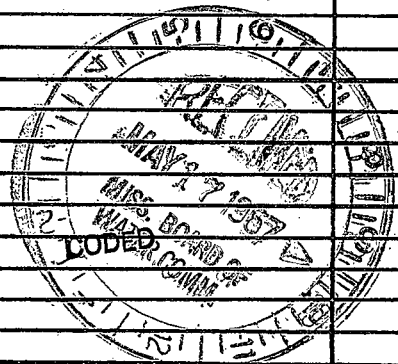

DRILLERS REMARKS:
Pump not installed -
No test run as of
this date.

If well telescopes please sketch and show depths.

GROUND LEVEL

			X

SECTION 5

Please indicate well location X.

ADDITIONAL INFORMATION

If more than one screen, show locations of each on sketch.