

Pike  
E6  
3-67

MISSISSIPPI  
BOARD OF WATER COMMISSIONERS  
416 North State Street  
Jackson, Mississippi 39201

WATER WELL DRILLERS LOG

March 23 1967 REEVES WELLS & PUMP Pike Co  
date well completed firm name county well located


LANDOWNER: Fenwood  
Industries  
Fenwood, Miss  
(mailing address)

description of formations encountered	from	to
bed clay	0	18
bed sand & gravel	18	50
bed gravel & sand	50	64

WELL LOCATION:  
sec. 31 T 3 N R 6 E  
in Fenwood  
(distance) (direction) (nearest town)

WELL PURPOSE: industrial  
(home, irrigation, municipal, industrial)


- WELL COMPLETION DATA:
- (1) diameter (inches) 4"
  - (2) total depth (feet) 64'
  - (3) static water level (feet) 4' below top of ground
  - (4) casing Plastic bottom (material) (depth)
  - 4" if telescope see back. (size)
  - (5) screen 6' 56' (length) (depth to top)
  - 4" Plastic (size) (material)
  - (6) pump 1/2 HP well (type power) (yield gpm)
  - Electric (type power)
  - (7) electric log NO (yes or no)
  - (organization running log)
  - (8) how well bottom plugged Plug wooden

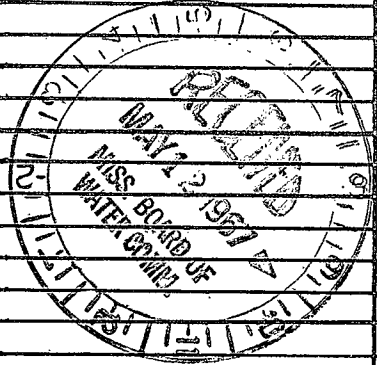

DRILLERS REMARKS:

If well telescopes please sketch and show depths.

GROUND LEVEL

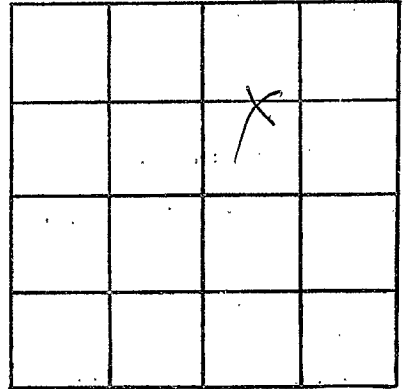

SECTION 31

Please indicate well location X.

ADDITIONAL INFORMATION

If more than one screen, show locations of each on sketch.