

PIKE
E II

CODED

MISSISSIPPI BOARD OF WATER COMMISSIONERS

7-12-60

WATER WELL DRILLERS LOG

E-300

Date 7-12, 1960 Driller Chester Reeves County Pike

Reeves well & Pump Co. (Name)

(1) Owner of Land: Oliver Booth
(Name)
RFD 2, McComb
(Address)

(2) Location: $\frac{1}{4}$, $\frac{1}{4}$, Sec. 10 T 8 R 3
5 miles EAST of McComb
(distance) (direction) (Nearest Town)

(3) Topography: Hilly
(Hilly) (Flat) (Level)

(4) Purpose of Well: Domestic
(Domestic Irrigation
Municipal, Industrial, Other)

Description & Color of Materials Sand, Clay, Red Clay, Shell, etc.	Thick- ness Feet	Depth Feet
Red clay	20	20
Yellow sand	55	75
Red sand		
Red clay sand		
Graavel	30	105
Pink clay	15	120
Graavel & Sand	15	135

Information upon completion of well:

(1) Diameter 2 inches.

(2) Total Depth 135 feet.

(3) Water Level 100 feet below top of ground.

(4) Cased to Bottom, Size _____

(5) Screen: Size 1 1/4", Length off


(6) Were any formations sealed against pollution?
_____ yes, no.

If YES depth of formation _____

Why _____

Drillers Remarks: _____

CODED

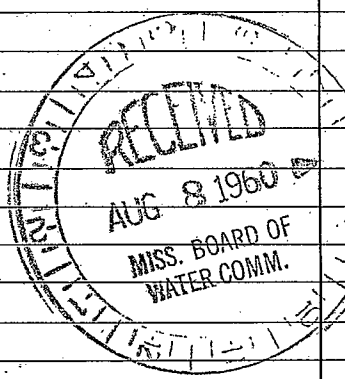

(Use Back Side)

Well No.

