

PIKE
E 13

MISSISSIPPI BOARD OF WATER COMMISSIONERS

11-21-61 CODED

WATER WELL DRILLERS LOG

Date: 11-21, 1961, Driller: Chester Reeves County Pike
(Name)

(1) Owner of Land:	Description & Color of Materials Sand, Clay, Red Clay, Shell, etc.	Thick- ness Feet
W. W. Tipton (Name) RFD 1, McComb (Address)	Red clay Sand & gravel	20 25
(2) Location: _____ 1/4, _____ 1/4, Sec. 29 T3 R8 3 miles S.E. of McComb (distance) (direction) (Nearest Town)	Red chalky Sand & gravel Coarse white sand and pea gravel	35 6
(3) Topography: <u>hilly</u> (Hilly) (Flat) (Level)		86
(4) Purpose of Well: <u>Domestic</u> (Domestic Irrigation Municipal, Industrial, Other)		

Information upon completion of well:


- (1) Diameter 4 inches.
- (2) Total Depth 86 feet.
- (3) Water Level 38 feet below top of ground.
- (4) Cased to Bottom Size 4"
- (5) Screen: Size None Length _____
- (6) Were any formations sealed against pollution?
_____ yes, no.

If YES depth of formation _____

Why _____

Drillers Remarks: old 2" well
went bad

CODED

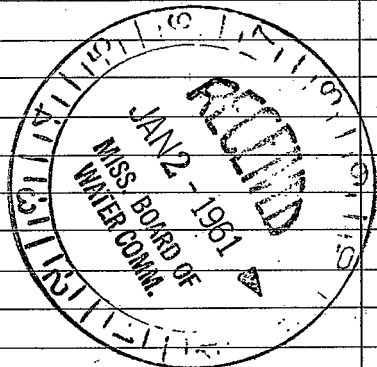

(Use Back Side)

