

PIKE

MISSISSIPPI BOARD OF WATER COMMISSIONERS

E 14

CODED

12-13-61

WATER WELL DRILLERS LOG

E

Date: 12-13, 1961, Driller: Chester Reese County Pike

(Name)

(1) Owner of Land: Mack Roberts
(Name)
RFD 2, McLamb
(Address)

(2) Location: 1/4, 1/4, Sec. 21 T. 3. R. 8,
4 miles East of McLamb
(distance) (direction) (Nearest Town)

(3) Topography: Hilly
(Hilly) (Flat) (Level)

(4) Purpose of Well: Domestic
(Domestic Irrigation
Municipal, Industrial, Other)

Description & Color of Materials Sand, Clay, Red Clay, Shell, etc.	Thick- ness Feet
Clay	25
Red Sand	53
Small Gravel	
Sand	10
Chalk	15
Yellow Coarse Sand	13
	118

Information upon completion of well:

(1) Diameter 2 inches.

(2) Total Depth 118 feet.

(3) Water Level 90 feet below top of ground.

(4) Cased to Bottom, Size 2"

(5) Screen: Size 1 1/4, Length 6' electric


(6) Were any formations sealed against pollution?
yes, no.

If YES depth of formation

Why

Drillers Remarks: good well
went bad.

CODED

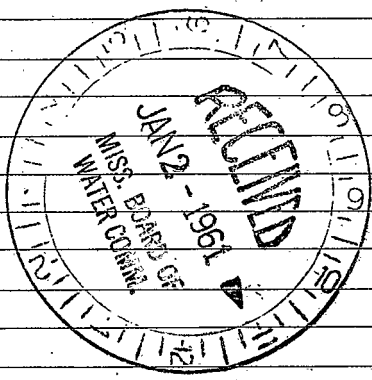

(Use Back Side)

