

PIKE
E 15

6-21-62 CODED

WATER WELL DRILLERS LOG

Date: 6/21, 1962, Driller: W. L. Massey County: Pike
(Name)

(1) Owner of Land: H. L. Mc Graw
(Name)
P. O. D. #1, Box 99, Mc Comb, Miss
(Address)

(2) Location: 1/4, 1/4, Sec. 3 T3 R8E
4 miles East, of Mc Comb,
(distance) (direction) (Nearest Town)

(3) Topography: Valley
(Hilly) (Flat) (Level)

(4) Purpose of Well: Domestic
(Domestic Irrigation
Municipal, Industrial, Other)

Description & Color of Materials Sand, Clay, Red Clay, Shell, etc.	Thick- ness Feet	Depth Feet
<u>Top soil and clay</u>	<u>0</u>	<u>20</u>
<u>Red sand</u>	<u>20</u>	<u>60</u>
<u>Red Clay</u>	<u>60</u>	<u>75</u>
<u>White clay</u>	<u>75</u>	<u>115</u>
<u>Blue clay</u>	<u>115</u>	<u>130</u>
<u>fine sand</u>	<u>130</u>	<u>140</u>
<u>Coarse white sand and gravel</u>	<u>140</u>	<u>151</u>

Information upon completion of well:

(1) Diameter 2 inches.

(2) Total Depth 151 feet.

(3) Water Level 60 feet below top of ground.

(4) Cased to 147, Size 2"


(5) Screen: Size 1/4", Length 4 ft.

(6) Were any formations sealed against pollution?
yes, no.

If YES depth of formation _____

Why _____

Drillers Remarks: _____

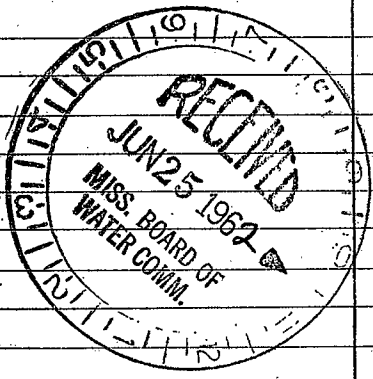

(Use Back Side)

Well No.

1917

The first part of the year was spent in the
 field, working on the various projects
 assigned to me. The weather was generally
 favorable, though there were some
 periods of heavy rain. The work was
 completed by the end of the year.

The second part of the year was spent in
 the office, working on the reports and
 other administrative matters. The work
 was completed by the end of the year.

The year was a successful one, and I
 am pleased to have completed the work
 assigned to me.