

PIKE
E18

11-24-62

CODED

WATER WELL DRILLERS LOG

Date: 11-24, 1962, Driller: Chester Reeves, County Pike
(Name)

(1) Owner of Land: L.B. Freeman
(Name)
RFD 2, McComb, Miss.
(Address)

(2) Location: 1/4, 1/4, Sec 10 T3R8
4 miles EAST, of McComb, Miss.
(distance) (direction) (Nearest Town)

(3) Topography: Hilly
(Hilly) (Flat) (Level)

(4) Purpose of Well: Domestic
(Domestic Irrigation
Municipal, Industrial, Other)

Description & Color of Materials (Sand, Clay, Red Clay, Shell, etc.)	Thick- ness Feet	Depth Feet
Red clay	20	20
Red sand-clay & gravel	50	70
Hard gravel sand	11	81

Information upon completion of well:

(1) Diameter 4 inches.


(2) Total Depth 81 feet.

(3) Water Level 55 feet below top of ground.

(4) Cased to Bottom, Size 4"

(5) Screen: Size 4", Length 4'

(6) Were any formations sealed against pollution?
yes, no.

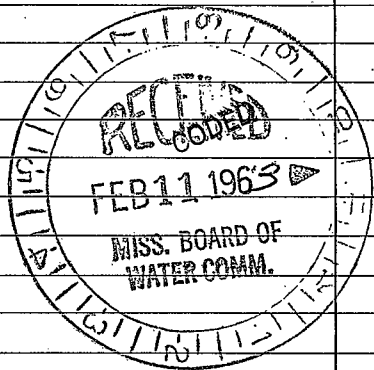

If YES depth of formation _____

Why _____

Drillers Remarks: old well sanded.

REEVES WELL & PUMP CO.
P. O. BOX 71 -:- PHONE 684-1451
McCOMB, MISS.

(Use Back Side)

Well No.

