

PIKE

E 20 CODED
MISSISSIPPI BOARD OF WATER COMMISSIONERS
5-10-66

MISSISSIPPI BOARD OF WATER COMMISSIONERS

WATER WELL DRILLERS LOG

Date: 5-10, 1966, Driller Chester Reeves County Pike
(When well drilled) (Name) (Where well is located)

(1) Owner of Land: Beatrice Dillon
D.F.D., McLamb
(Name) (Address)
(2) Location: 1/4, 1/4, Sec. 33 T3R8
4 miles East of Fernwood
(distance) (direction) (Nearest Town)
(3) Topography: Hilly
(Hilly) (Flat) (Level)
(4) Purpose of Well: Domestic
(Domestic Irrigation) (Municipal, Industrial, Other)

Description & Color of Materials Sand, Clay, Red Clay, Shell, etc.	Thick- ness Feet	Depth Feet
Red clay	17	17
Loose sand	43	60
Hard gravel	20	80
Mixed chalk sand and gravel	15	95
Reagan sand	7	102

Information upon completion of well:


(1) Diameter 4 inches.
(2) Total Depth 102 feet.
(3) Water Level 8.5 feet below top of ground.
(4) Cased to Bottom Size 4
(5) Screen: Size 4", Length 6'
(6) Were any formations sealed against pollution?
yes, X no.

If YES depth of formation

Why

Drillers Remarks: Well had
Yield in gpm: kinked 17
Size pump: 1/2 HP - sub
Type power: Electric

CODED

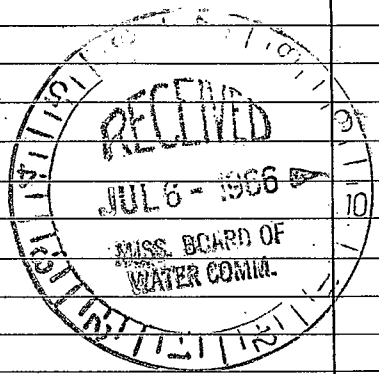

REEVES WELL & PUMP CO.
P. O. BOX 71 -- PHONE 684-1451
McCOMB, MISS.

1870