

Pike

E21

6-66 CODED

MISSISSIPPI BOARD OF WATER COMMISSIONERS

WATER WELL DRILLERS LOG

Date: June 28, 1966, Driller: Chester Reeves County: Pike
(When well drilled) (Name) (Where well is located)

(1) Owner of Land: K. L. Ford
(Name)
Rt 2, M. Lamb
(Address)

(2) Location: 1/4, 1/4, Sec. 22 T3R8
4 miles East of M. Lamb
(distance) (direction) (Nearest Town)

(3) Topography: Hilly
(Hilly) (Flat) (Level)

(4) Purpose of Well: Domestic
(Domestic Irrigation
Municipal, Industrial, Other)

| Description & Color of Materials Sand, Clay, Red Clay, Shell, etc. | Thick- ness Feet | Depth Feet |
|---|------------------------|---------------|
| <u>Red Clay</u> | <u>20</u> | <u>20</u> |
| <u>Red Sand</u> | <u>25</u> | <u>45</u> |
| <u>Hardpan</u> | <u>58</u> | <u>103</u> |

Information upon completion of well:

(1) Diameter 4 inches.

(2) Total Depth 103 feet.

(3) Water Level 69 feet below top of ground.

(4) Cased to Bottom Size 4"

(5) Screen: Size 4", Length 6"

(6) Were any formations sealed against pollution?
_____ yes, no.

CODED

If YES depth of formation _____


Why _____

Drillers Remarks: old well weak

Yield in gpm: 15

Size pump: 1/2 HP. Sub

Type power: Electric

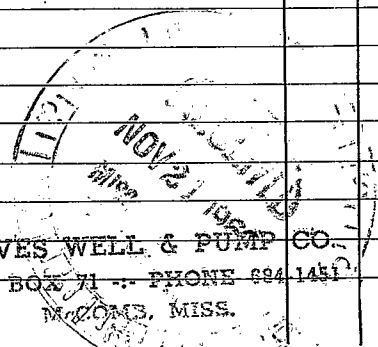

REEVES WELL & PUMP CO.
P. O. BOX 71 -- PHONE 694-1451
MCCOMB, MISS.

