

Pike
E23
9-66

MISSISSIPPI BOARD OF WATER COMMISSIONERS

WATER WELL DRILLERS LOG

Date: 9 3, 1966, Driller: A. H. Wiley County Pike
(When well drilled) (Name) (Where well is located)

1) Owner of Land:	Description & Color of Materials Sand, Clay, Red Clay, Shell, etc.	Thick- ness Feet	Depth Feet
<u>Kettie Brown</u> <small>(Name)</small>	<u>Topsoil & Clay</u>	<u>20</u>	<u>20</u>
<u>McComb Rt 1</u> <small>(Address)</small>	<u>Red Sand</u>	<u>30</u>	<u>50</u>
2) Location: <u>NE 1/4, NW 1/4, Sec 32</u> <small>(distance) (direction) (Nearest Town)</small>	<u>Heavy gravel</u>	<u>7</u>	<u>57</u>
3) Topography: <u>Hilly</u> <small>(Hilly) (Flat) (Level)</small>	<u>Red Sand</u>	<u>10</u>	<u>67</u>
4) Purpose of Well: <u>Domestic</u> <small>(Domestic Irrigation Municipal, Industrial, Other)</small>	<u>Red Sand Gravel</u>	<u>18</u>	<u>85</u>

Information upon completion of well:

1) Diameter 4 inches.

2) Total Depth 110 feet.

3) Water Level 85 feet below top of ground.

4) Cased to 10 2 Size _____

5) Screen: Size 4", Length 8'

6) Were any formations sealed against pollution?
 _____ yes, _____ no.

CODED

YES depth of formation _____


Why _____

Drillers Remarks: _____

Yield in gpm: _____

Size pump: _____

Type power: _____

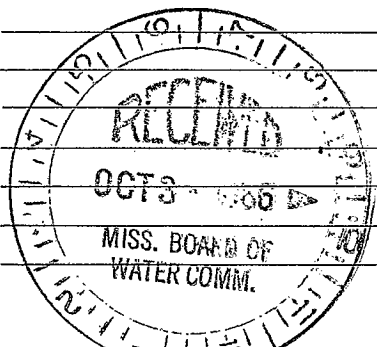

Mail this copy to Board of Water Commissioners 429 Miss. St. Jackson, Miss.

