

Pike
E24
9-66

MISSISSIPPI BOARD OF WATER COMMISSIONERS

CODED

WATER WELL DRILLERS LOG

Date: 9-5-1966, Driller: WJ Fitzgerald County Pike
 (When well drilled) (Name) (Where well is located)


1) Owner of Land: Frank Powell
 (Name)
RH McCormick
 (Address)
 2) Location: SF 1/4, SW 1/4, Sec. 8 T. 2 R. 8
2 miles E of McCormick
 (distance) (direction) (Nearest Town)
 3) Topography: Hilly
 (Hilly) (Flat) (Level)
 4) Purpose of Well: Domestic
 (Domestic Irrigation
 Municipal, Industrial, Other)

Description & Color of Materials Sand, Clay, Red Clay, Shell, etc.	Thick- ness Feet	Depth Feet
<u>top soil & red clay</u>	<u>30</u>	<u>30</u>
<u>red chalk</u>	<u>15</u>	<u>45</u>
<u>red sand</u>	<u>20</u>	<u>65</u>
<u>red sand gravel</u>	<u>20</u>	<u>85</u>
<u>loose sand</u>	<u>10</u>	<u>95</u>
<u>sand & gravel</u>	<u>10</u>	<u>105</u>
<u>Chalk</u>	<u>?</u>	<u>105</u>

Information upon completion of well:

1) Diameter 2 inches.
 2) Total Depth 105 feet.
 3) Water Level 85 feet below top of ground.
 4) Cased to 102, Size _____
 5) Screen: Size 1/4, Length 3'
 6) Were any formations sealed against pollution?
 _____ yes, no.
 YES depth of formation _____
 by _____
 Drillers Remarks: _____
 Yield in gpm: 3
 Size pump: 1/2 Rod
 Type power: Electric

CODED

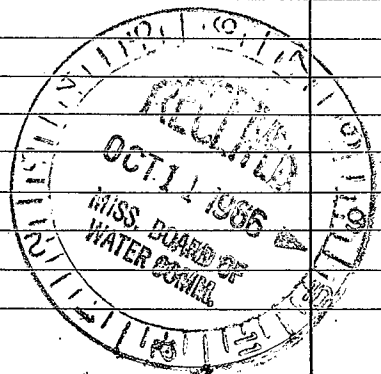

File this copy to Board of Water Commissioners 429 Miss. St. Jackson, Miss.

1875