

Pike
E 26
11-66 CODED

MISSISSIPPI
BOARD OF WATER COMMISSIONERS
416 North State Street
Jackson, Mississippi 39201

WATER WELL DRILLERS LOG

Nov, 23 1966 Reeves & Kemp - Pike
date well completed firm name county well located

LANDOWNER: EDDIE
Lowrey
RFD 1, McComb
(mailing address)


description of formations encountered	from	to
Red clay	0	20
yellowish sandy	20	65
sand & gravel	65	72

WELL LOCATION:
sec. 29 T. 30 N. R. 8 E
3 miles S.E. of McComb
(distance) (direction) (nearest town)

WELL PURPOSE: Domestic
(home, irrigation, municipal, industrial)

- WELL COMPLETION DATA:
- (1) diameter (inches) 4"
 - (2) total depth (feet) 72
 - (3) static water level (feet) 60 below top of ground.
 - (4) casing Plastic Bottom
(material) (depth)
 - (5) screen 6' (length) 60' (depth to top)
4" (size) Plastic (material)
 - (6) pump 1/2 HP 5 (yield gpm)
Electric (type power)
 - (7) electric log NO
(yes or no)

CODED

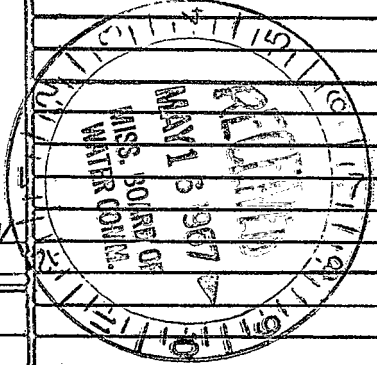


(organization running log)
(8) how well bottom plugged
Reeves & Kemp

DRILLERS REMARKS:

If well telescopes please sketch and show depths.

GROUND LEVEL

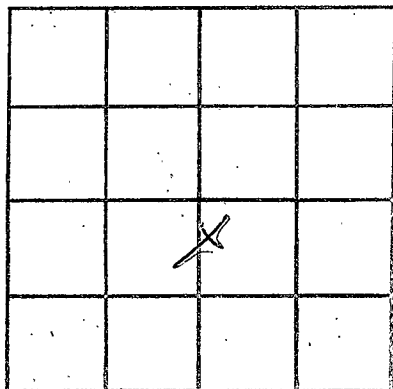

SECTION _____

Please indicate well location X.

ADDITIONAL INFORMATION

If more than one screen,
show locations of each on sketch.