

Pike CODED
E27
12-66

MISSISSIPPI
BOARD OF WATER COMMISSIONERS
416 North State Street
Jackson, Mississippi 39201

WATER WELL DRILLERS LOG

22 Dec 1966 J.T. Carver & Son Pike
date well completed firm name county well located

LANDOWNER: Charles Stehlig

description of formations encountered	from	to
	clay	0
Chalk	50	80
Sand	80	120

M^cComb, Miss.
(mailing address)

WELL LOCATION:
sec. 31 T. 3 N R. 8 E
S W
1 1/2 miles East of Fenwood
(distance) (direction) (nearest town)


WELL PURPOSE:
(home, irrigation, municipal, industrial)

- WELL COMPLETION DATA:
- (1) diameter (inches) 16"
 - (2) total depth (feet) 120
 - (3) static water level (feet) 80 above top of ground.
 - (4) casing Plastic, 114" (material), (depth),
4" (size) if telescope see back.
 - (5) screen 6' (length), 114" (depth to top)
4" (size), Plastic (material)
 - (6) pump 1/2 (HP), 10 (yield gpm)
Sube (type power)
 - (7) electric log No (yes or no)
(organization running log)

(8) how well bottom plugged wood plug


DRILLERS REMARKS:

CODED

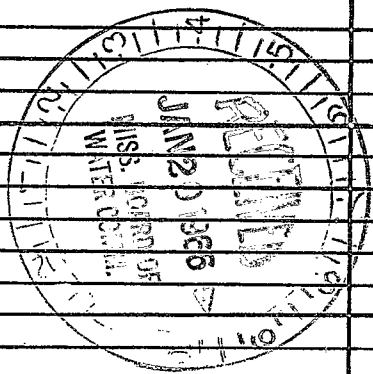

If well telescopes please sketch and show depths.

GROUND LEVEL

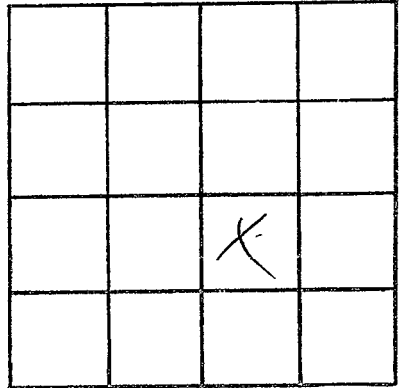

SECTION 31

Please indicate well location X.

ADDITIONAL INFORMATION

If more than one screen,
show locations of each on sketch.