

Pike
E29 UDED
3-67

MISSISSIPPI
BOARD OF WATER COMMISSIONERS
416 North State Street
Jackson, Mississippi 39201

WATER WELL DRILLERS LOG

Mar 8 1967 date well completed
Fitzgibbon Bros firm name
Pike county well located

LANDOWNER: A. L. Long

description of formations encountered

Route Magnolia
(mailing address)

	from	to
Red clay	6	25
Red sand	25	75
Red sand & gravel	75	90
Coarse sand & gravel	90	100

WELL LOCATION:


sec. 33 T. 3 N R. 8 E
2 1/2 miles E of Ferriswood
(distance) (direction) (nearest town)

WELL PURPOSE: Home
(home, irrigation, municipal, industrial)

WELL COMPLETION DATA:

- diameter (inches) 8
- total depth (feet) 100
- static water level (feet) 88 below top of ground.
- casing Plastic 92 (material), (depth)
4" (size) if telescope see back.
- screen 8' 92 (length), (depth to top)
4" (size), Plastic (material)
- pump 1/2 (HP), 12 (yield gpm)
Elec (type power)
- electric log No (yes or no)
(organization running log)
- how well bottom plugged Wood plug


CODED

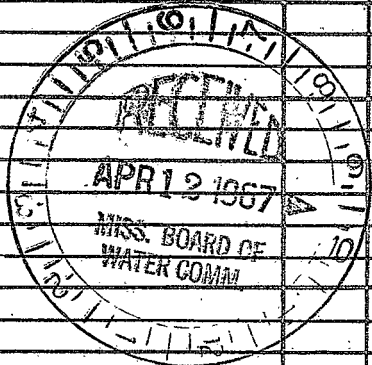

DRILLERS REMARKS:

If well telescopes please sketch and show depths.

GROUND LEVEL

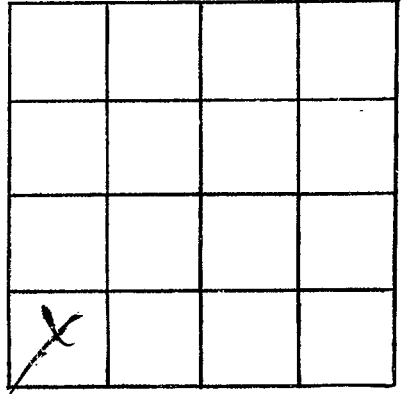

SECTION 

Please indicate well location X.

ADDITIONAL INFORMATION

If more than one screen,
show locations of each on sketch.