

PIKE CODED

E30

3-67

MISSISSIPPI BOARD OF WATER COMMISSIONERS
416 North State Street
Jackson, Mississippi 39201

WATER WELL DRILLERS LOG

March 28 1967 REEVES WELLDRILLING PIKE
date well completed firm name county well located

LANDOWNER: Gene Deer

RFD 1, McLomb
(mailing address)

WELL LOCATION:

sec 28 T 3 N R 4 E
4 miles SE of McLomb
(distance) (direction) (nearest town)

WELL PURPOSE: Home
(home, irrigation, municipal, industrial)

WELL COMPLETION DATA:

- (1) diameter (inches) 4"
- (2) total depth (feet) 109
- (3) static water level (feet) 42 below top of ground.
- (4) casing Plastic Bottom
(material) (depth)
- 4" If telescope see back.
(size)
- (5) screen 6' 103'
(length) (depth to top)
- 4" Plastic
(size) (material)
- Reeves Pump 12
(type pump) (yield gpm)
- Electric
(type power)
- (7) electric log NO
(yes or no)


(organization running log)

(8) how well bottom plugged water plug

DRILLERS REMARKS:


description of formations encountered	from	to
clay gravel	0	25
Red Sand gravel	25	67
Hard gravel	67	72
white chalk	72	92
Big gravel	92	109

CODED

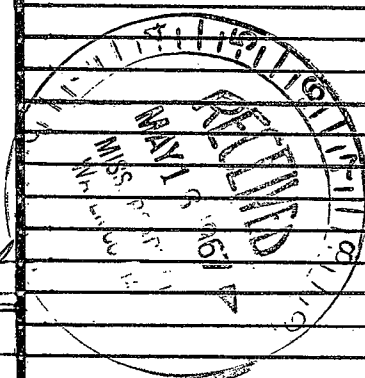

If well telescopes please sketch and show depths.

GROUND LEVEL

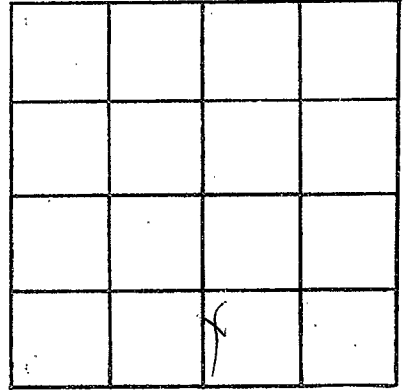

SECTION 28

Please indicate well location X.

ADDITIONAL INFORMATION

If more than one screen,
show locations of each on sketch.