

Pike  
E32  
4-67

MISSISSIPPI  
BOARD OF WATER COMMISSIONERS  
416 North State Street  
Jackson, Mississippi 39201

WATER WELL DRILLERS LOG

Apr 27 1967 Fitzgerald Well Driller Pike  
date well completed firm name county well located

LANDOWNER:  
Pleasant Grove Church  
Route 1, 7th Camb Miss.  
(mailing address)


WELL LOCATION:  
sec. 35 T. 3 N. R. 8 E  
4 miles E of Farmersburg  
(distance) (direction) (nearest town)

WELL PURPOSE: Domestic  
(home, irrigation, municipal, industrial)

- WELL COMPLETION DATA:
- (1) diameter (inches) 4
  - (2) total depth (feet) 138
  - (3) static water level (feet) 100 below top of ground.
  - (4) casing Plastic, 130'  
(material) (depth)  
4" if telescope see back.  
(size)
  - (5) screen 8', 130'  
(length) (depth to top)  
4', Plastic  
(size) (material)
  - (6) pump 1 8  
(HP) (yield gpm)  
Electric  
(type power)
  - (7) electric log No  
(yes or no)  
(organization running log)
  - (8) how well bottom plugged Wood peg

description of formations encountered	from	to
<u>Red clay</u>	<u>0</u>	<u>10</u>
<u>Red chalk</u>	<u>10</u>	<u>30</u>
<u>Red sand</u>	<u>30</u>	<u>50</u>
<u>Red gravel</u>	<u>50</u>	<u>60</u>
<u>Red sand &amp; gravel</u>	<u>60</u>	<u>80</u>
<u>Red sand</u>	<u>80</u>	<u>100</u>
<u>White chalk</u>	<u>100</u>	<u>110</u>
<u>Coarse sand</u>	<u>110</u>	<u>125</u>
<u>Coarse sand &amp; gravel</u>	<u>125</u>	<u>138</u>


CODED

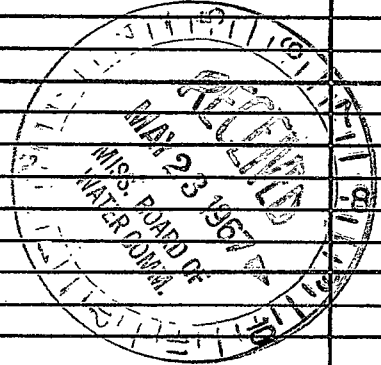

DRILLERS REMARKS:

If well telescopes please sketch and show depths.

GROUND LEVEL

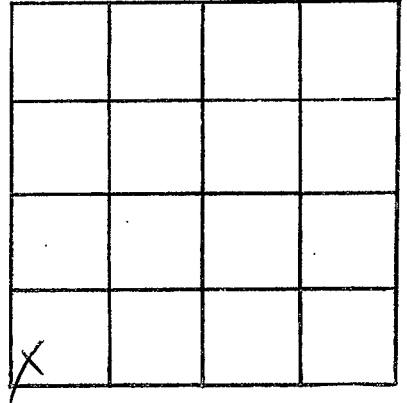

SECTION 35

Please indicate well location X.

ADDITIONAL INFORMATION

If more than one screen,  
show locations of each on sketch.