

**MISSISSIPPI  
BOARD OF WATER COMMISSIONERS**  
416 North State Street  
Jackson, Mississippi 39201

**WATER WELL DRILLERS LOG**

PIKE  
E 34  
6-67

6-27 19 67 Fitzgerald Water Well Pike  
date well completed firm name county well located

LANDOWNER: R. K. Bennett  
R. H. McComb, Miss

description of formations encountered	from	to
<u>Dirt &amp; Chalk</u>	<u>0</u>	<u>12</u>
<u>Gravel &amp; Sand</u>	<u>12</u>	<u>16</u>
<u>Fine Red Sand</u>	<u>16</u>	<u>50</u>
<u>Coarse Sand</u>	<u>50</u>	<u>65</u>

(mailing address)

**WELL LOCATION:**


sec 3 T 3 N 8 E  
S W  
5 miles E of McComb  
(distance) (direction) (nearest town)

WELL PURPOSE: home  
(home, irrigation, municipal, industrial)

**WELL COMPLETION DATA:**


- (1) diameter (inches) 4
- (2) total depth (feet) 63
- (3) static water level (feet) 10 below above top of ground.
- (4) casing plastic, 57,  
(material) (depth)  
4 if telescope see back.  
(size)
- (5) screen 6', 57  
(length) (depth to top)  
4, plastic  
(size) (material)
- (6) pump — —  
(HP) (yield gpm)  
—  
(type power)
- (7) electric log NO  
(yes or no)  
—  
(organization running log)
- (8) how well bottom plugged Wood peg

DRILLERS REMARKS:

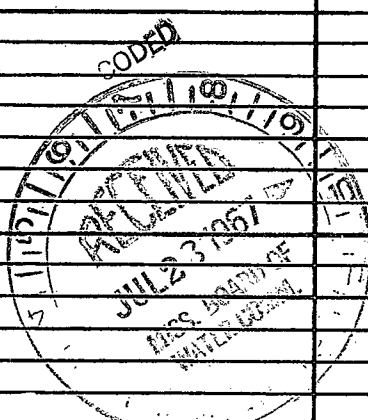

If well telescopes please sketch and show depths.

GROUND LEVEL

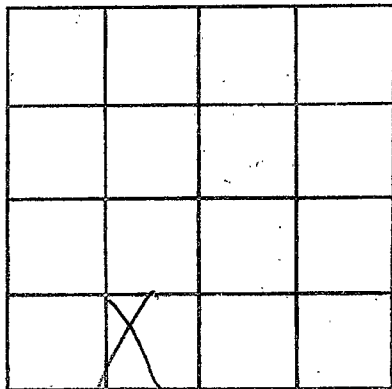

SECTION 3

Please indicate well location X.

ADDITIONAL INFORMATION

If more than one screen, show locations of each on sketch.